


1 RCP
SCALE: 1/8" = 1'-0"

TYP FACTORY WELDED SEAM IN MEMBRANE @ 132" O.C.

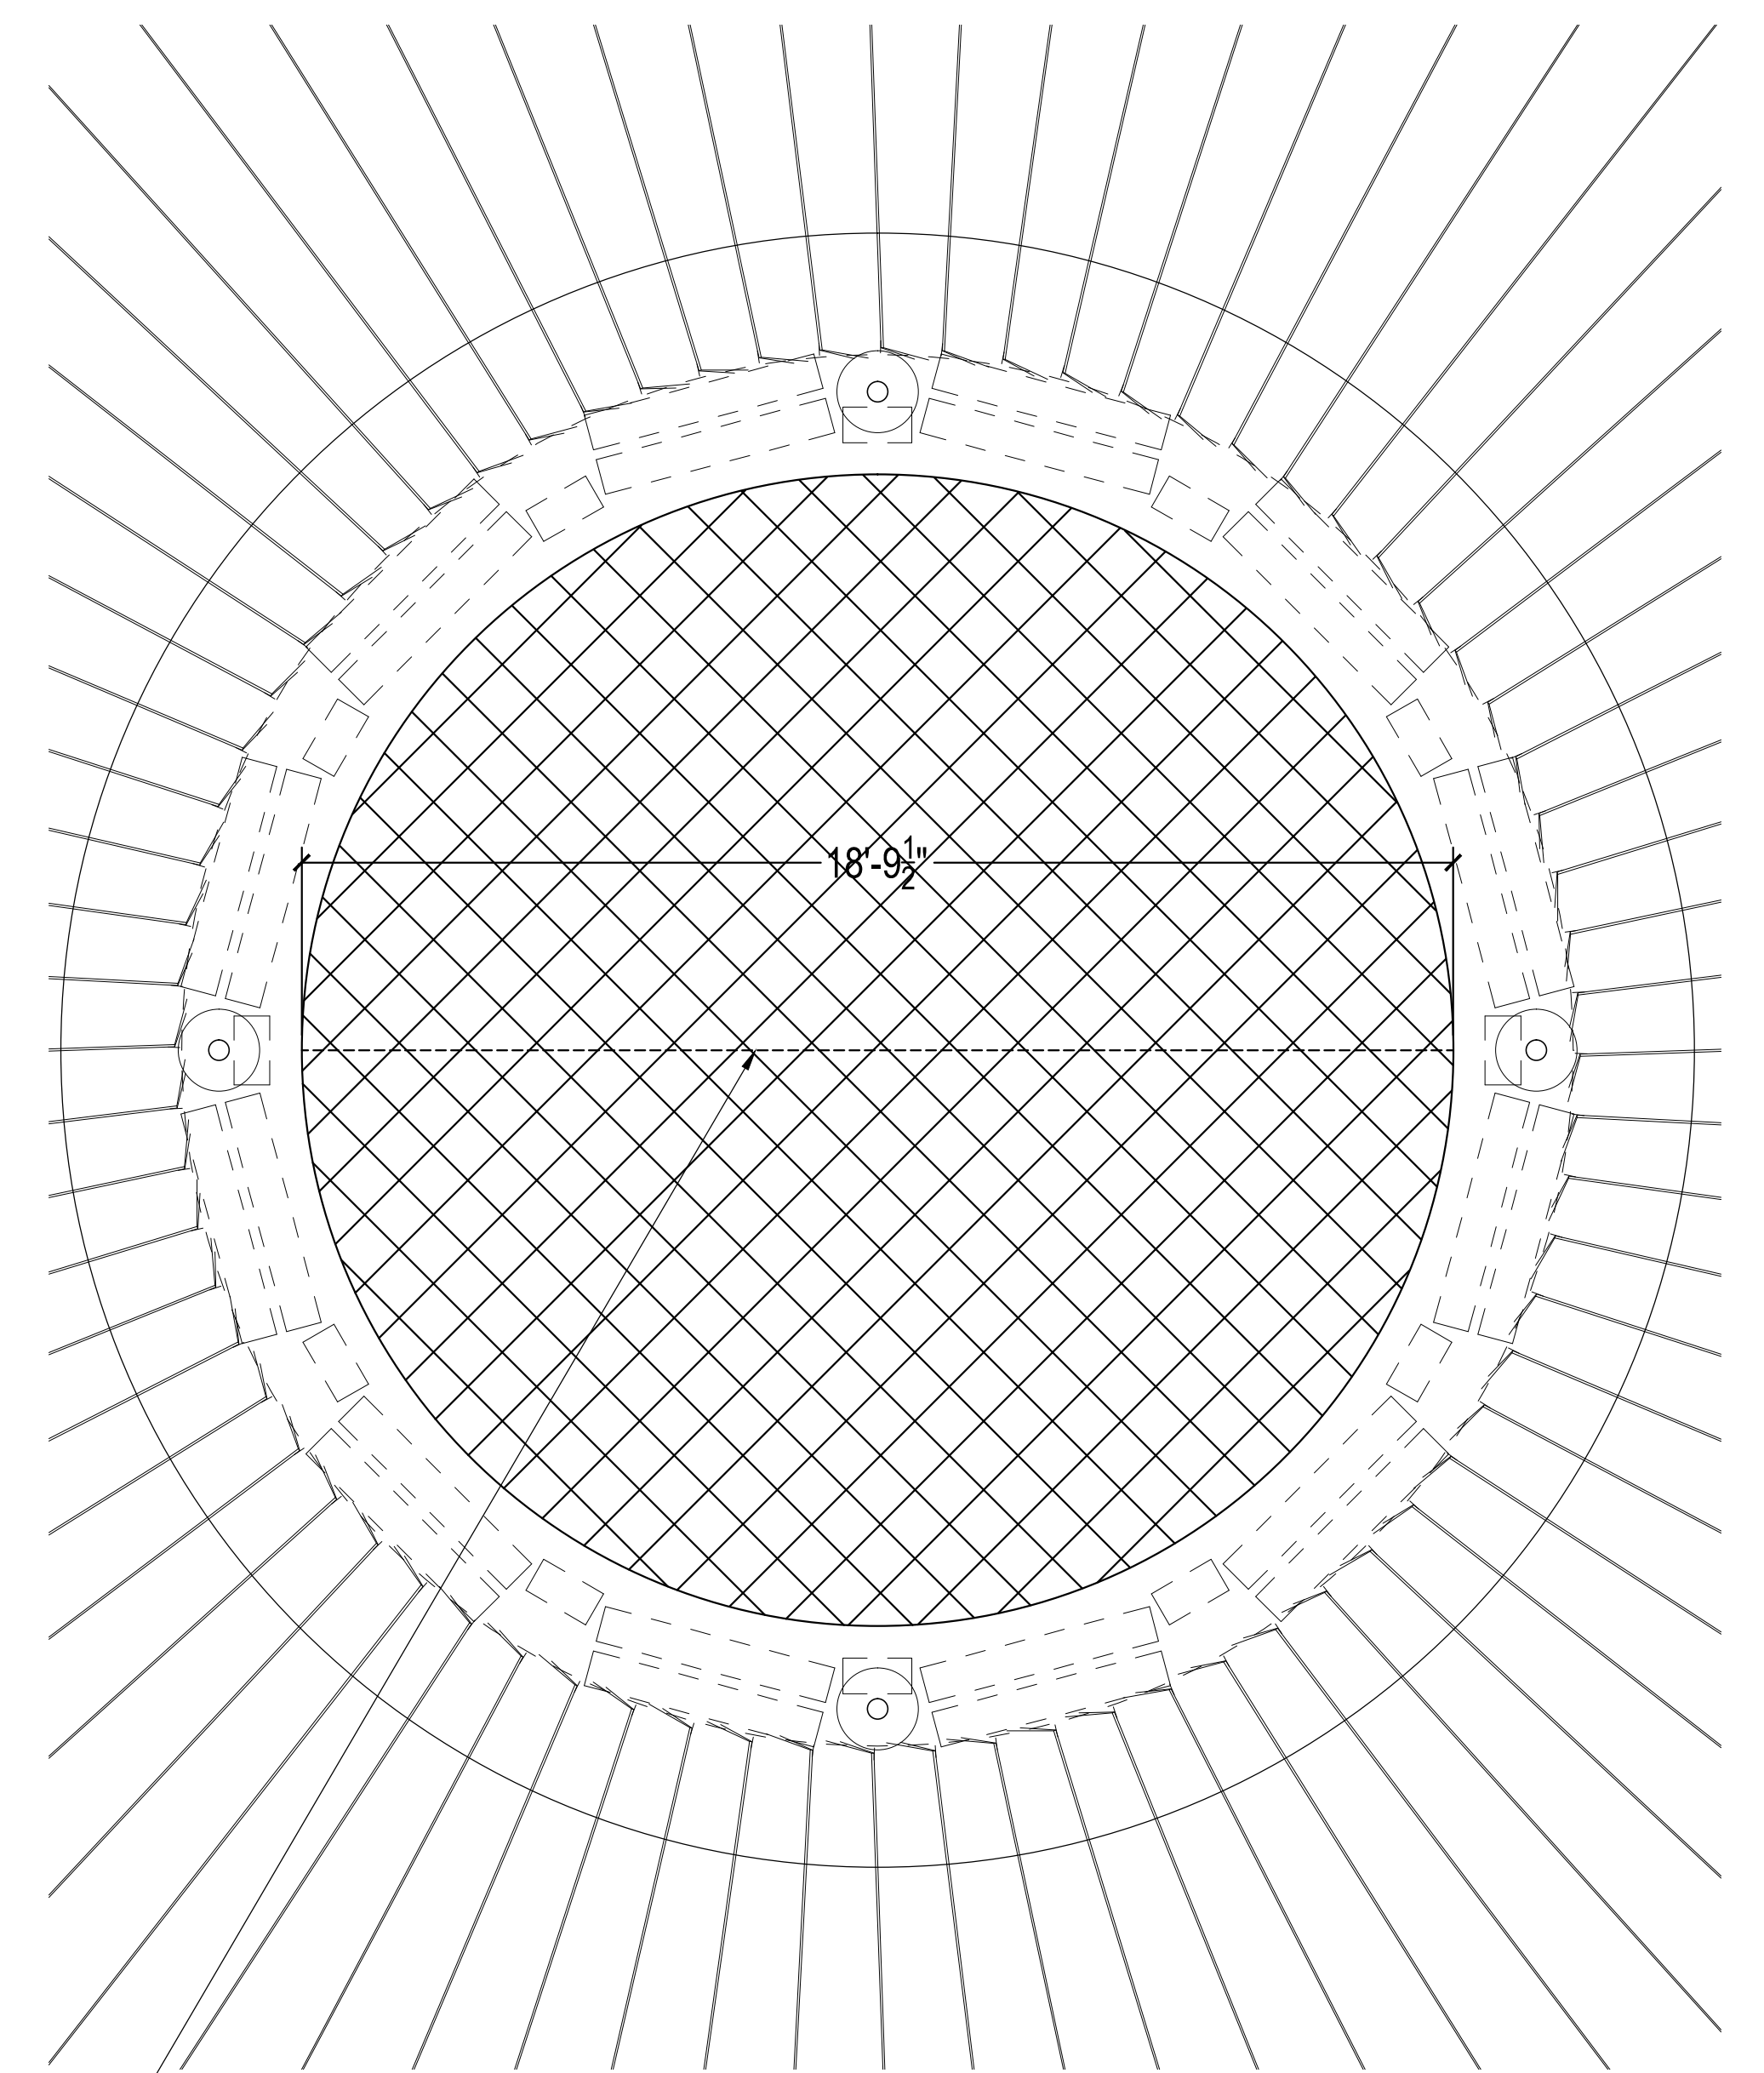


2 ENLARGED RCP @ OCULUS
SCALE: 1/8" = 1'-0"

NOTES:
 1) ALL DIMENSIONS AND LOCATIONS MUST BE V.I.F. PRIOR TO NEWMAT FABRICATION AND INSTALLATION.
 2) ALL DRYWALL APPLICATIONS REQUIRE 12" CONTINUOUS 16GA (MINIMUM) METAL STRAPPING REINFORCEMENT BEHIND DRYWALL AT ALL NEWMAT ATTACHMENT LOCATIONS.
 3) ALL "BLOCKING BY OTHERS", MUST BE CONTINUOUS, STRAIGHT, LEVEL AND/OR PLUMB AND ABLE TO WITHSTAND 30LBS. PER LINEAR FOOT OF LATERAL TENSION WHICH WILL BE EXERTED BY EACH LAYER OF MEMBRANE.

AS BUILT
10/3/2019

NOTICE:
 THESE DRAWINGS WERE PRODUCED BY AND ARE THE SOLE PROPERTY OF NEWMAT USA LTD ANY AND ALL INFORMATION CONTAINED HEREIN SHALL NOT BE USED BY ANY OTHER PERSON OR COMPANY WITHOUT THE EXPRESSED WRITTEN CONSENT OF NEWMAT USA LTD. THE DRAWINGS MAY HAVE BEEN BASED ON CONSTRUCTION DRAWINGS NOT PREPARED BY NEWMAT USA LTD. THEREFORE MAY NOT REPRESENT THE CONDITIONS AS CONSTRUCTED AT THAT TIME.

NEWMAT NORTHEAST CORP. <i>newmat</i> STRETCH CEILING SYSTEMS	#	REVISIONS	Drawn By	Checked By	81 MAHAN STREET, WEST BABYLON, NY 11704 TEL: (631) 261 1498 FAX: (631) 261 1756	Scale:	Drawn By:
	A	2/26/2018	R.K.			AS NOTED	R.K.
	B	3/1/2018	R.K.				
	C	3/7/2018	R.K.				
	D	3/15/2018	R.K.				
E	5/4/2018	R.K.					
					Job Title:	Job Number:	Date:
					RCP	13-000	2/14/2018
					Customer Name:	Drawing Number:	
					AMERICAN AIRLINES	A-01	
					AMERICAN AIRLINES		

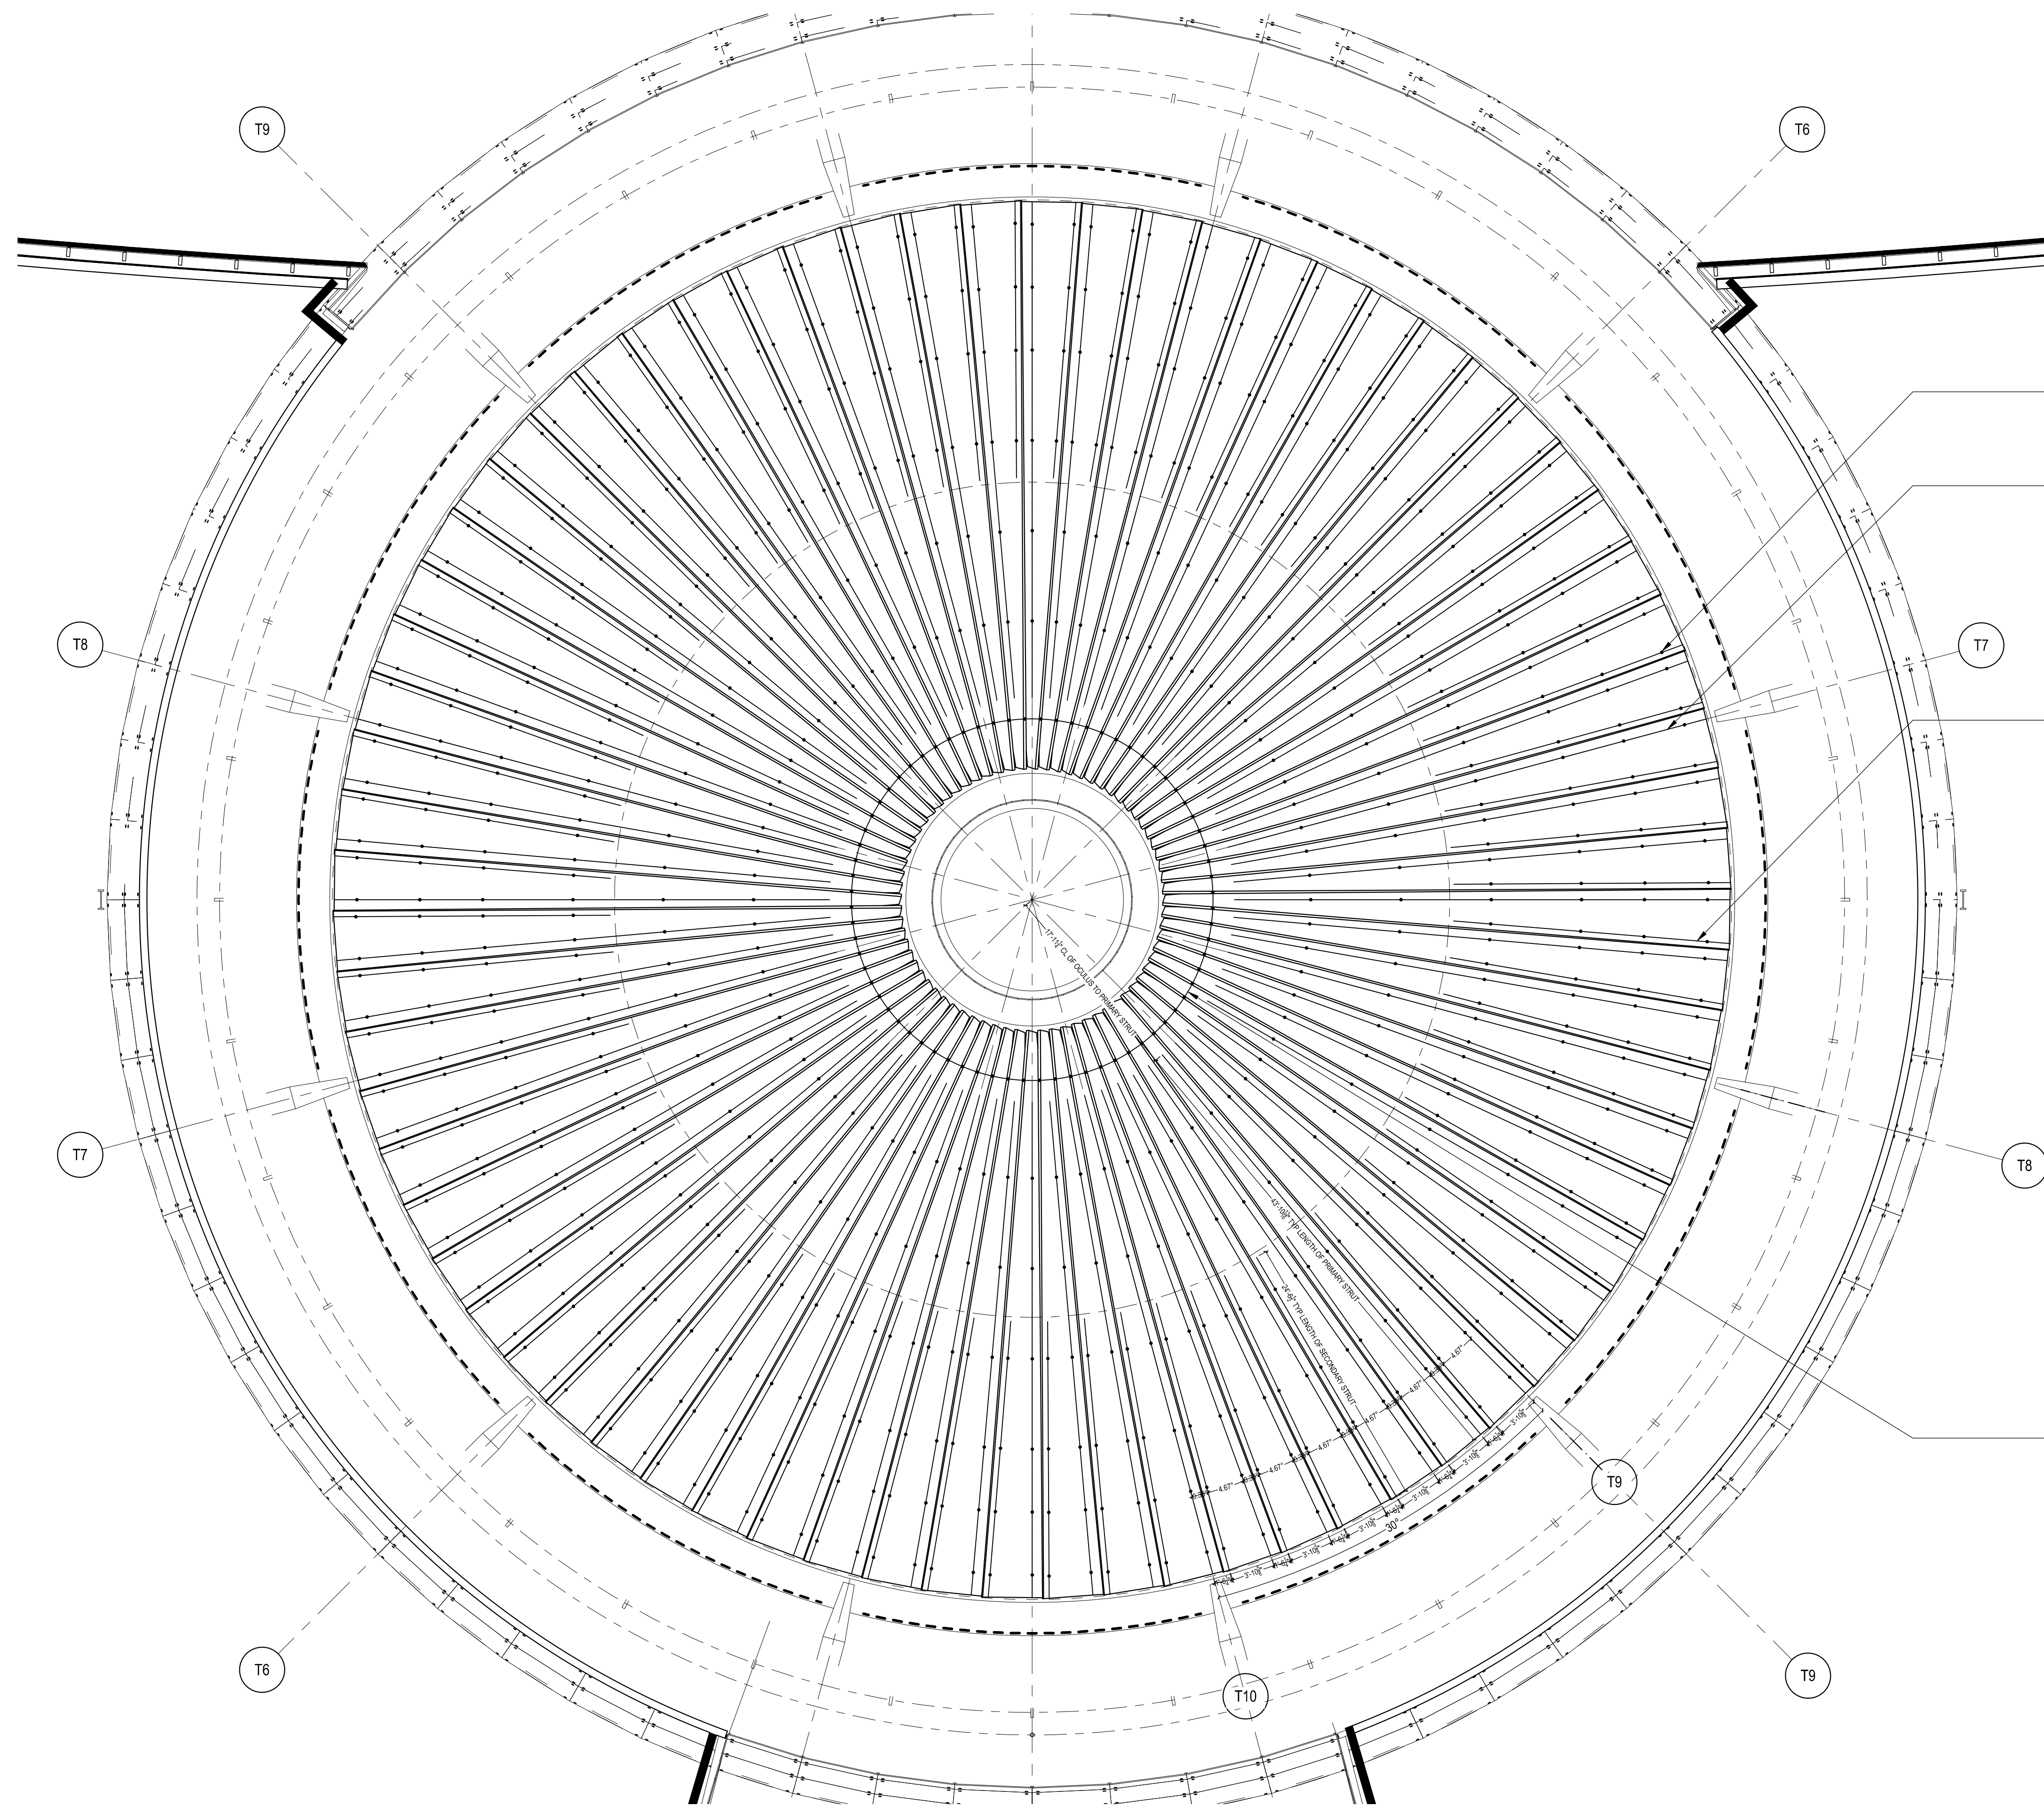

LOCATION OF SUSPENSION CABLES @ 8'-0" O.C.

PRIMARY UNISTRUT ABOVE EACH BLADE
ALIGNED W/ CENTERLINE (BY MAREK BROTHERS)

SECONDARY UNISTRUT ABOVE EACH BLADE
12" IN FROM WIDE EDGE (BY MAREK BROTHERS)

UNISTRUT RING BELOW CATWALK
4'-4" FROM END OF BLADE (BY MAREK BROTHERS)


1 RCP
SCALE: 1/8" = 1'-0"

- NOTES:**
- 1) ALL DIMENSIONS AND LOCATIONS MUST BE V.I.F. PRIOR TO NEWMAT FABRICATION AND INSTALLATION.
 - 2) ALL DRYWALL APPLICATIONS REQUIRE 12" CONTINUOUS 16GA (MINIMUM) METAL STRAPPING REINFORCEMENT BEHIND DRYWALL AT ALL NEWMAT ATTACHMENT LOCATIONS.
 - 3) ALL "BLOCKING BY OTHERS" MUST BE CONTINUOUS, STRAIGHT, LEVEL AND/OR PLUMB AND ABLE TO WITHSTAND 30LBS. PER LINEAR FOOT OF LATERAL TENSION WHICH WILL BE EXERTED BY EACH LAYER OF MEMBRANE.

AS BUILT
10/3/2019

NOTICE:
THESE DRAWINGS WERE PRODUCED BY AND ARE THE SOLE PROPERTY OF NEWMAT USA LTD ANY AND ALL INFORMATION CONTAINED HEREIN SHALL NOT BE USED BY ANY OTHER PERSON OR COMPANY WITHOUT THE EXPRESSED WRITTEN CONSENT OF NEWMAT USA LTD. THE DRAWINGS MAY HAVE BEEN BASED ON CONSTRUCTION DRAWINGS NOT PREPARED BY NEWMAT USA LTD. THEREFORE MAY NOT REPRESENT THE CONDITIONS AS CONSTRUCTED AT THAT TIME.

NEWMAT NORTHEAST CORP. STRETCH CEILING SYSTEMS	#	REVISIONS:	Drawn	Checked	81 MAHAN STREET, WEST BABYLON, NY 11704 TEL: (631) 261 1498 FAX: (631) 261 1756 Drawing Title: UNISTRUT LAYOUT Job Title: AMERICAN AIRLINES Customer Name: AMERICAN AIRLINES	Scale:	Drawn By:
	A	2/26/2018	R.K.			AS NOTED	Checked By:
	B	3/1/2018	R.K.			Job Number:	Date:
	C	3/7/2018	R.K.			13-000	2/14/2018
	D	3/15/2018	R.K.			Drawing Number:	
E	5/4/2018	R.K.		A-01.1			

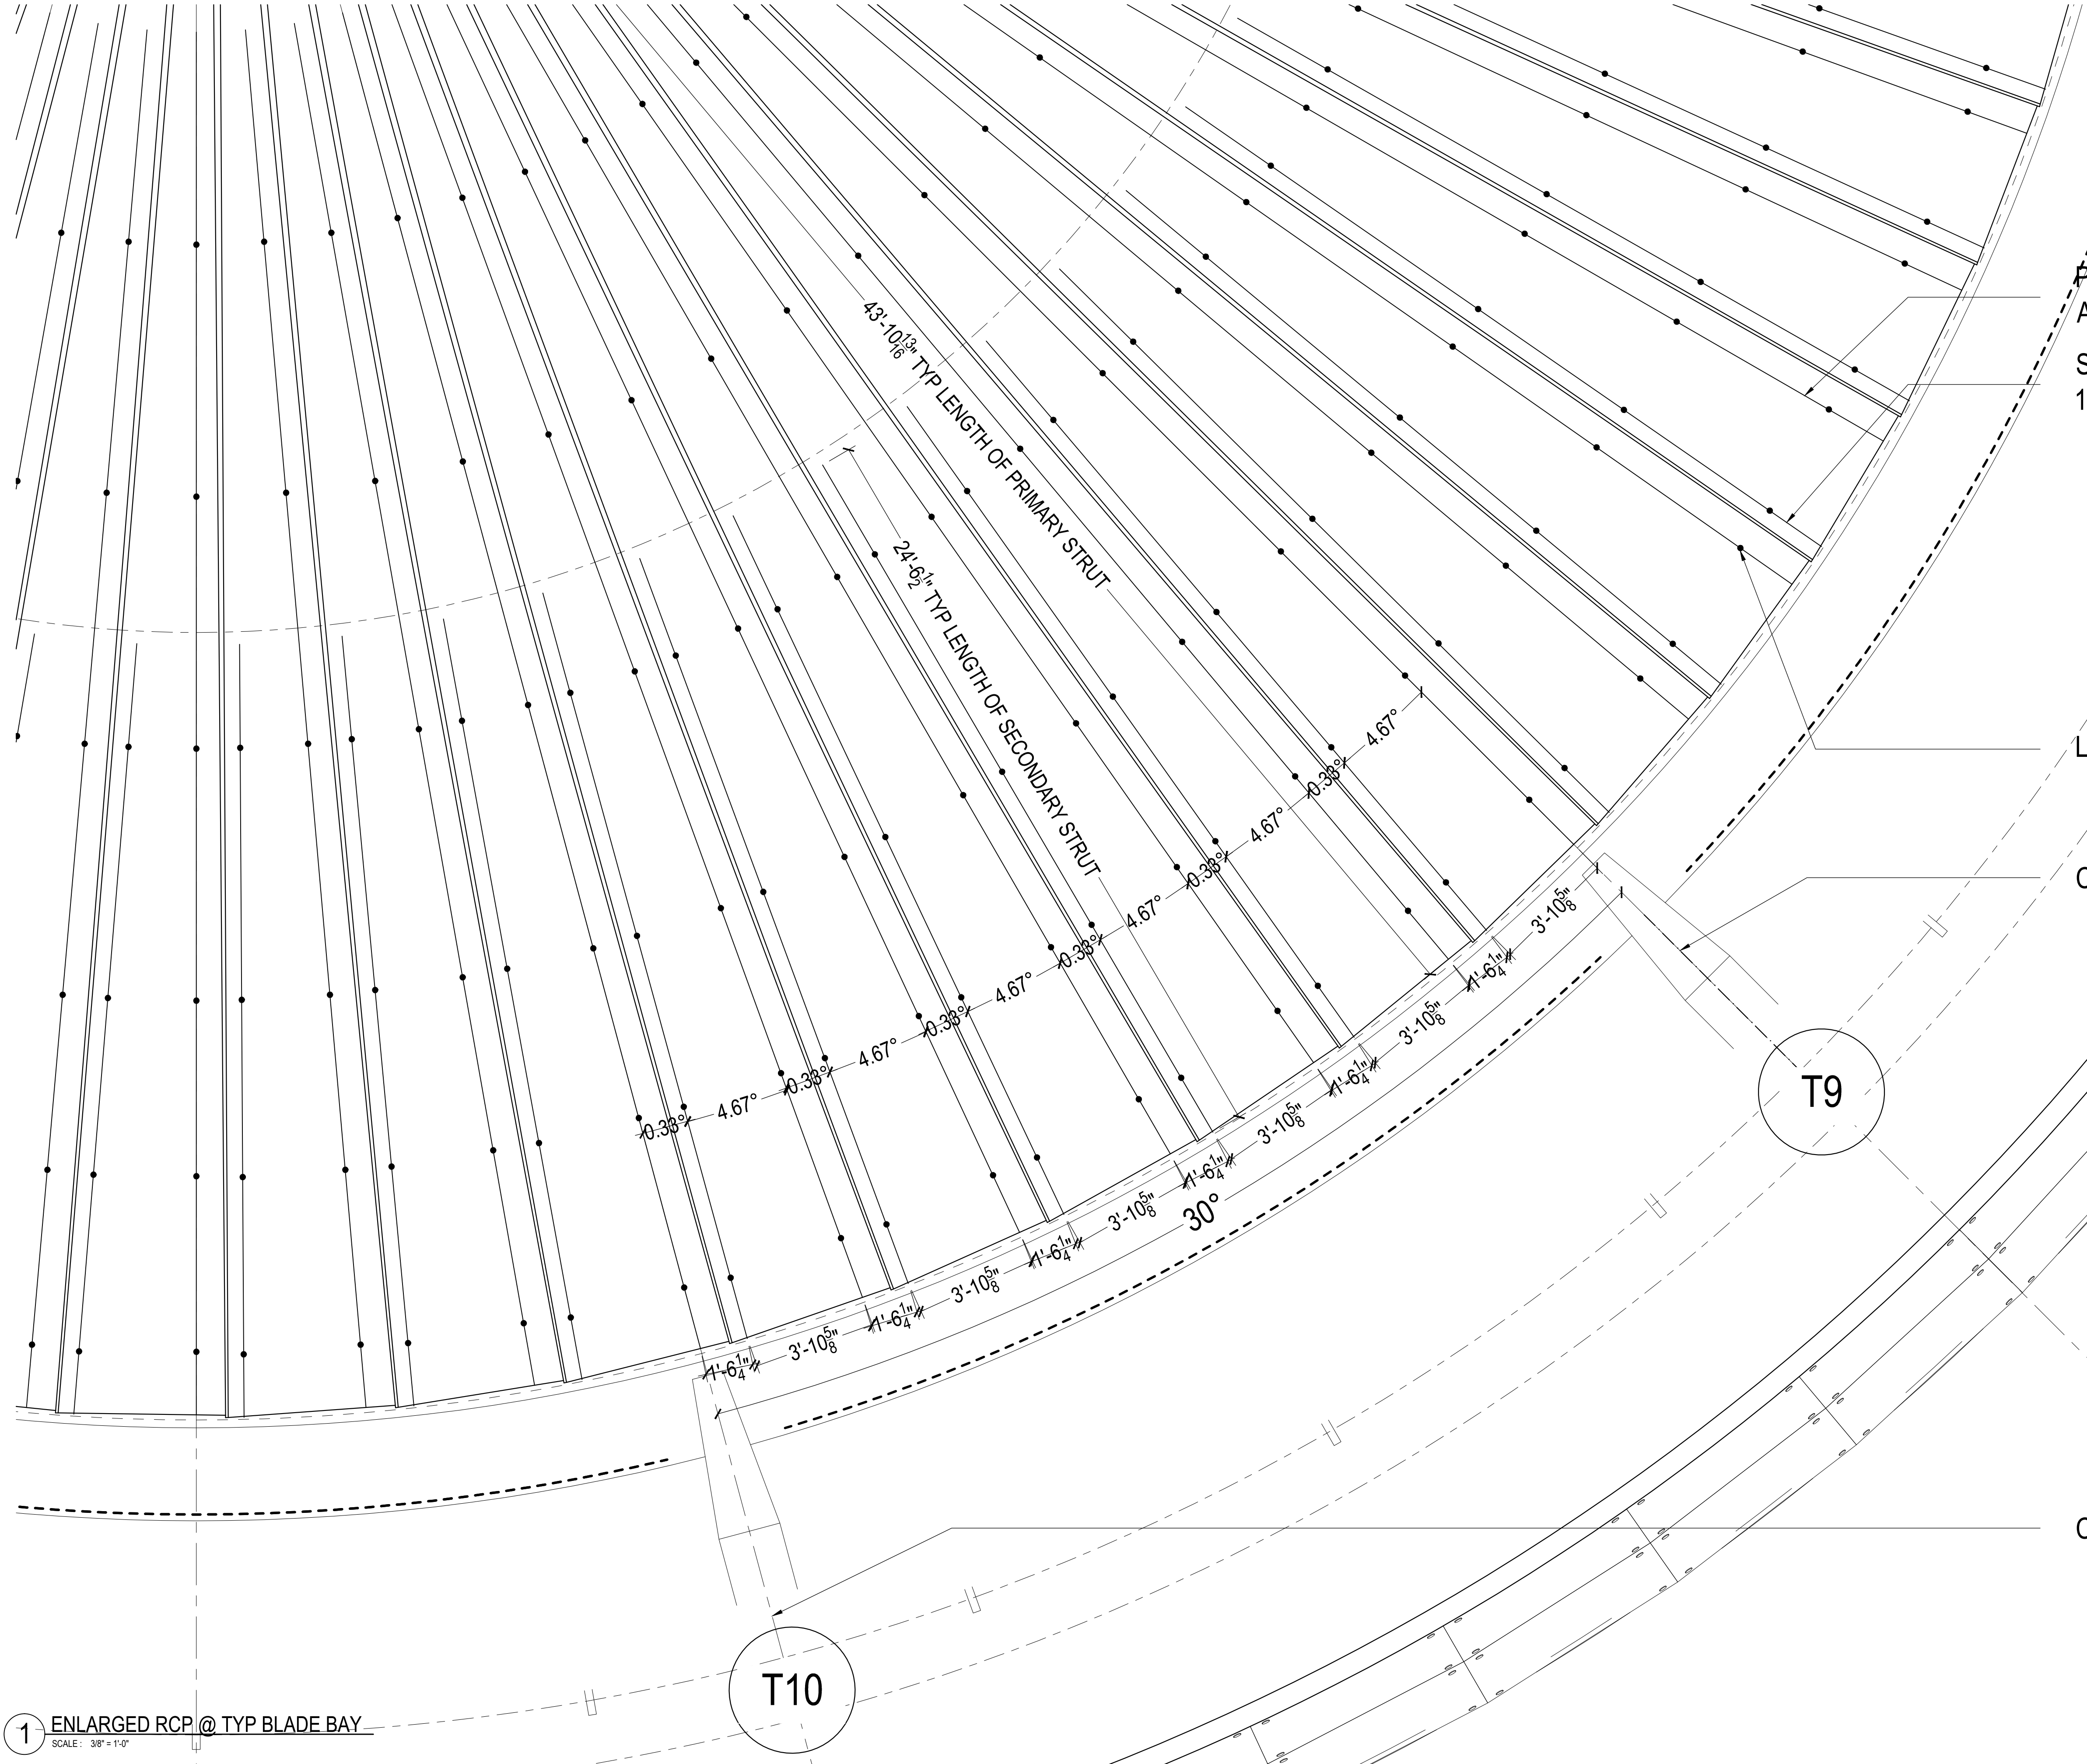

PRIMARY UNISTRUT ABOVE EACH BLADE
 ALIGNED W/ CENTERLINE (BY MAREK BROTHERS)

SECONDARY UNISTRUT ABOVE EACH BLADE
 12" IN FROM WIDE EDGE (BY MAREK BROTHERS)

LOCATION OF SUSPENSION CABLES @ 8'-0" O.C.

CENTERLINE OF STRUT CHANNEL ALIGNED W/ COLUMN LINE

CENTERLINE OF STRUT CHANNEL ALIGNED W/ COLUMN LINE

T9

T10

1 ENLARGED RCP @ TYP BLADE BAY
 SCALE: 3/8" = 1'-0"


NOTES:

- 1) ALL DIMENSIONS AND LOCATIONS MUST BE V.I.F. PRIOR TO NEWMAT FABRICATION AND INSTALLATION.
- 2) ALL DRYWALL APPLICATIONS REQUIRE 12" CONTINUOUS 16GA (MINIMUM) METAL STRAPPING REINFORCEMENT BEHIND DRYWALL AT ALL NEWMAT ATTACHMENT LOCATIONS.
- 3) ALL "BLOCKING BY OTHERS", MUST BE CONTINUOUS, STRAIGHT, LEVEL AND/OR PLUMB AND ABLE TO WITHSTAND 30LBS. PER LINEAR FOOT OF LATERAL TENSION WHICH WILL BE EXERTED BY EACH LAYER OF MEMBRANE.

AS BUILT
10/3/2019

NOTICE:
 THESE DRAWINGS WERE PRODUCED BY AND ARE THE SOLE PROPERTY OF NEWMAT USA LTD AND ALL INFORMATION CONTAINED HEREIN SHALL NOT BE USED BY ANY OTHER PERSON OR COMPANY WITHOUT THE EXPRESSED WRITTEN CONSENT OF NEWMAT USA LTD. THE DRAWINGS MAY HAVE BEEN BASED ON CONSTRUCTION DRAWINGS NOT PREPARED BY NEWMAT USA LTD. THEREFORE MAY NOT REPRESENT THE CONDITIONS AS CONSTRUCTED AT THAT TIME.

NEWMAT NORTHEAST CORP. 	#	REVISIONS:	Drawn By	Checked By	81 MAHAN STREET, WEST BABYLON, NY 11704 TEL. (631) 261 1498 FAX (631) 261 1756 Drawing Title: ENLARGED RCP Job Title: AMERICAN AIRLINES Customer Name: AMERICAN AIRLINES	Scale:	Drawn By:
	A	2/26/2018	R.K.			AS NOTED	Checked By:
	B	3/1/2018	R.K.			Job Number:	Date:
	C	3/7/2018	R.K.			13-000	2/14/2018
	D	3/15/2018	R.K.			Drawing Number:	
E	5/4/2018	R.K.		A-01.2			

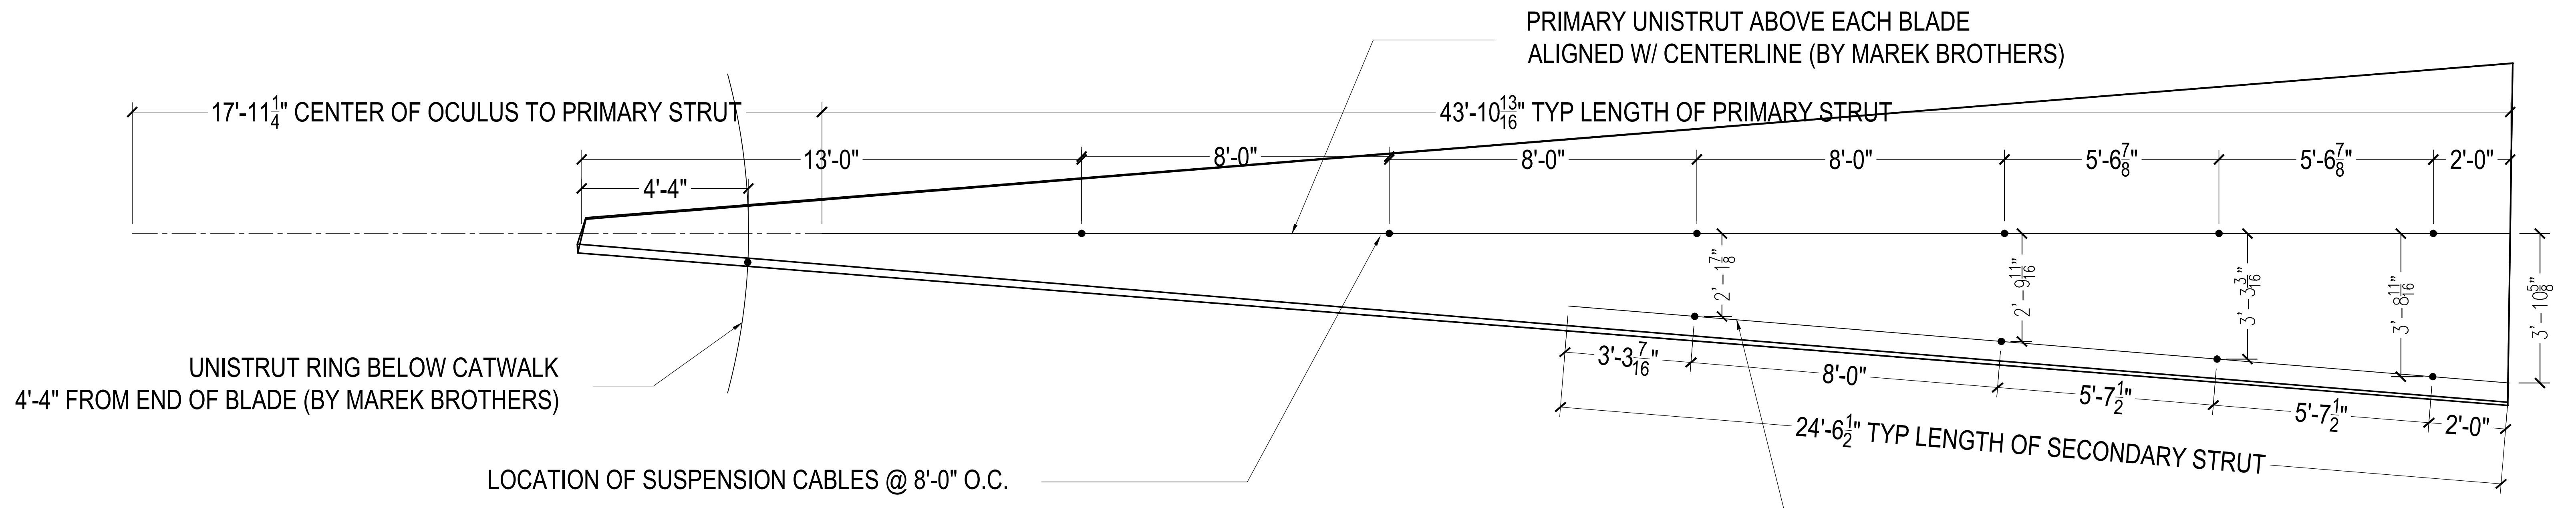


1 ENLARGED RCP @ TYP BLADE
SCALE: 1/2" = 1'-0"

NOTES:
 1) ALL DIMENSIONS AND LOCATIONS MUST BE V.I.F. PRIOR TO NEWMAT FABRICATION AND INSTALLATION.
 2) ALL DRYWALL APPLICATIONS REQUIRE 12" CONTINUOUS 16GA (MINIMUM) METAL STRAPPING REINFORCEMENT BEHIND DRYWALL AT ALL NEWMAT ATTACHMENT LOCATIONS.
 3) ALL "BLOCKING BY OTHERS", MUST BE CONTINUOUS, STRAIGHT, LEVEL AND/OR PLUMB AND ABLE TO WITHSTAND 30LBS. PER LINEAR FOOT OF LATERAL TENSION WHICH WILL BE EXERTED BY EACH LAYER OF MEMBRANE.

AS BUILT
10/3/2019

NOTICE:
 THESE DRAWINGS WERE PRODUCED BY AND ARE THE SOLE PROPERTY OF NEWMAT USA LTD AND ALL INFORMATION CONTAINED HEREIN SHALL NOT BE USED BY ANY OTHER PERSON OR COMPANY WITHOUT THE EXPRESSED WRITTEN CONSENT OF NEWMAT USA LTD. THE DRAWINGS MAY HAVE BEEN BASED ON CONSTRUCTION DRAWINGS NOT PREPARED BY NEWMAT USA LTD. THEREFORE MAY NOT REPRESENT THE CONDITIONS AS CONSTRUCTED AT THAT TIME.

NEWMAT NORTHEAST CORP. STRETCH CEILING SYSTEMS	#	REVISIONS:	Drawn	Checked	81 MAHAN STREET, WEST BABYLON, NY 11704 TEL. (631) 261 1498 FAX (631) 261 1756 Drawing Title: ENLARGED RCP Job Title: AMERICAN AIRLINES Customer Name: AMERICAN AIRLINES	Scale:	Drawn By:
	A	2/26/2018	R.K.			AS NOTED	R.K.
	B	3/1/2018	R.K.			Job Number:	Checked By:
	C	3/7/2018	R.K.			13-000	Date:
	D	3/15/2018	R.K.			2/14/2018	
E	5/4/2018	R.K.			Drawing Number:		
						A-01.3	

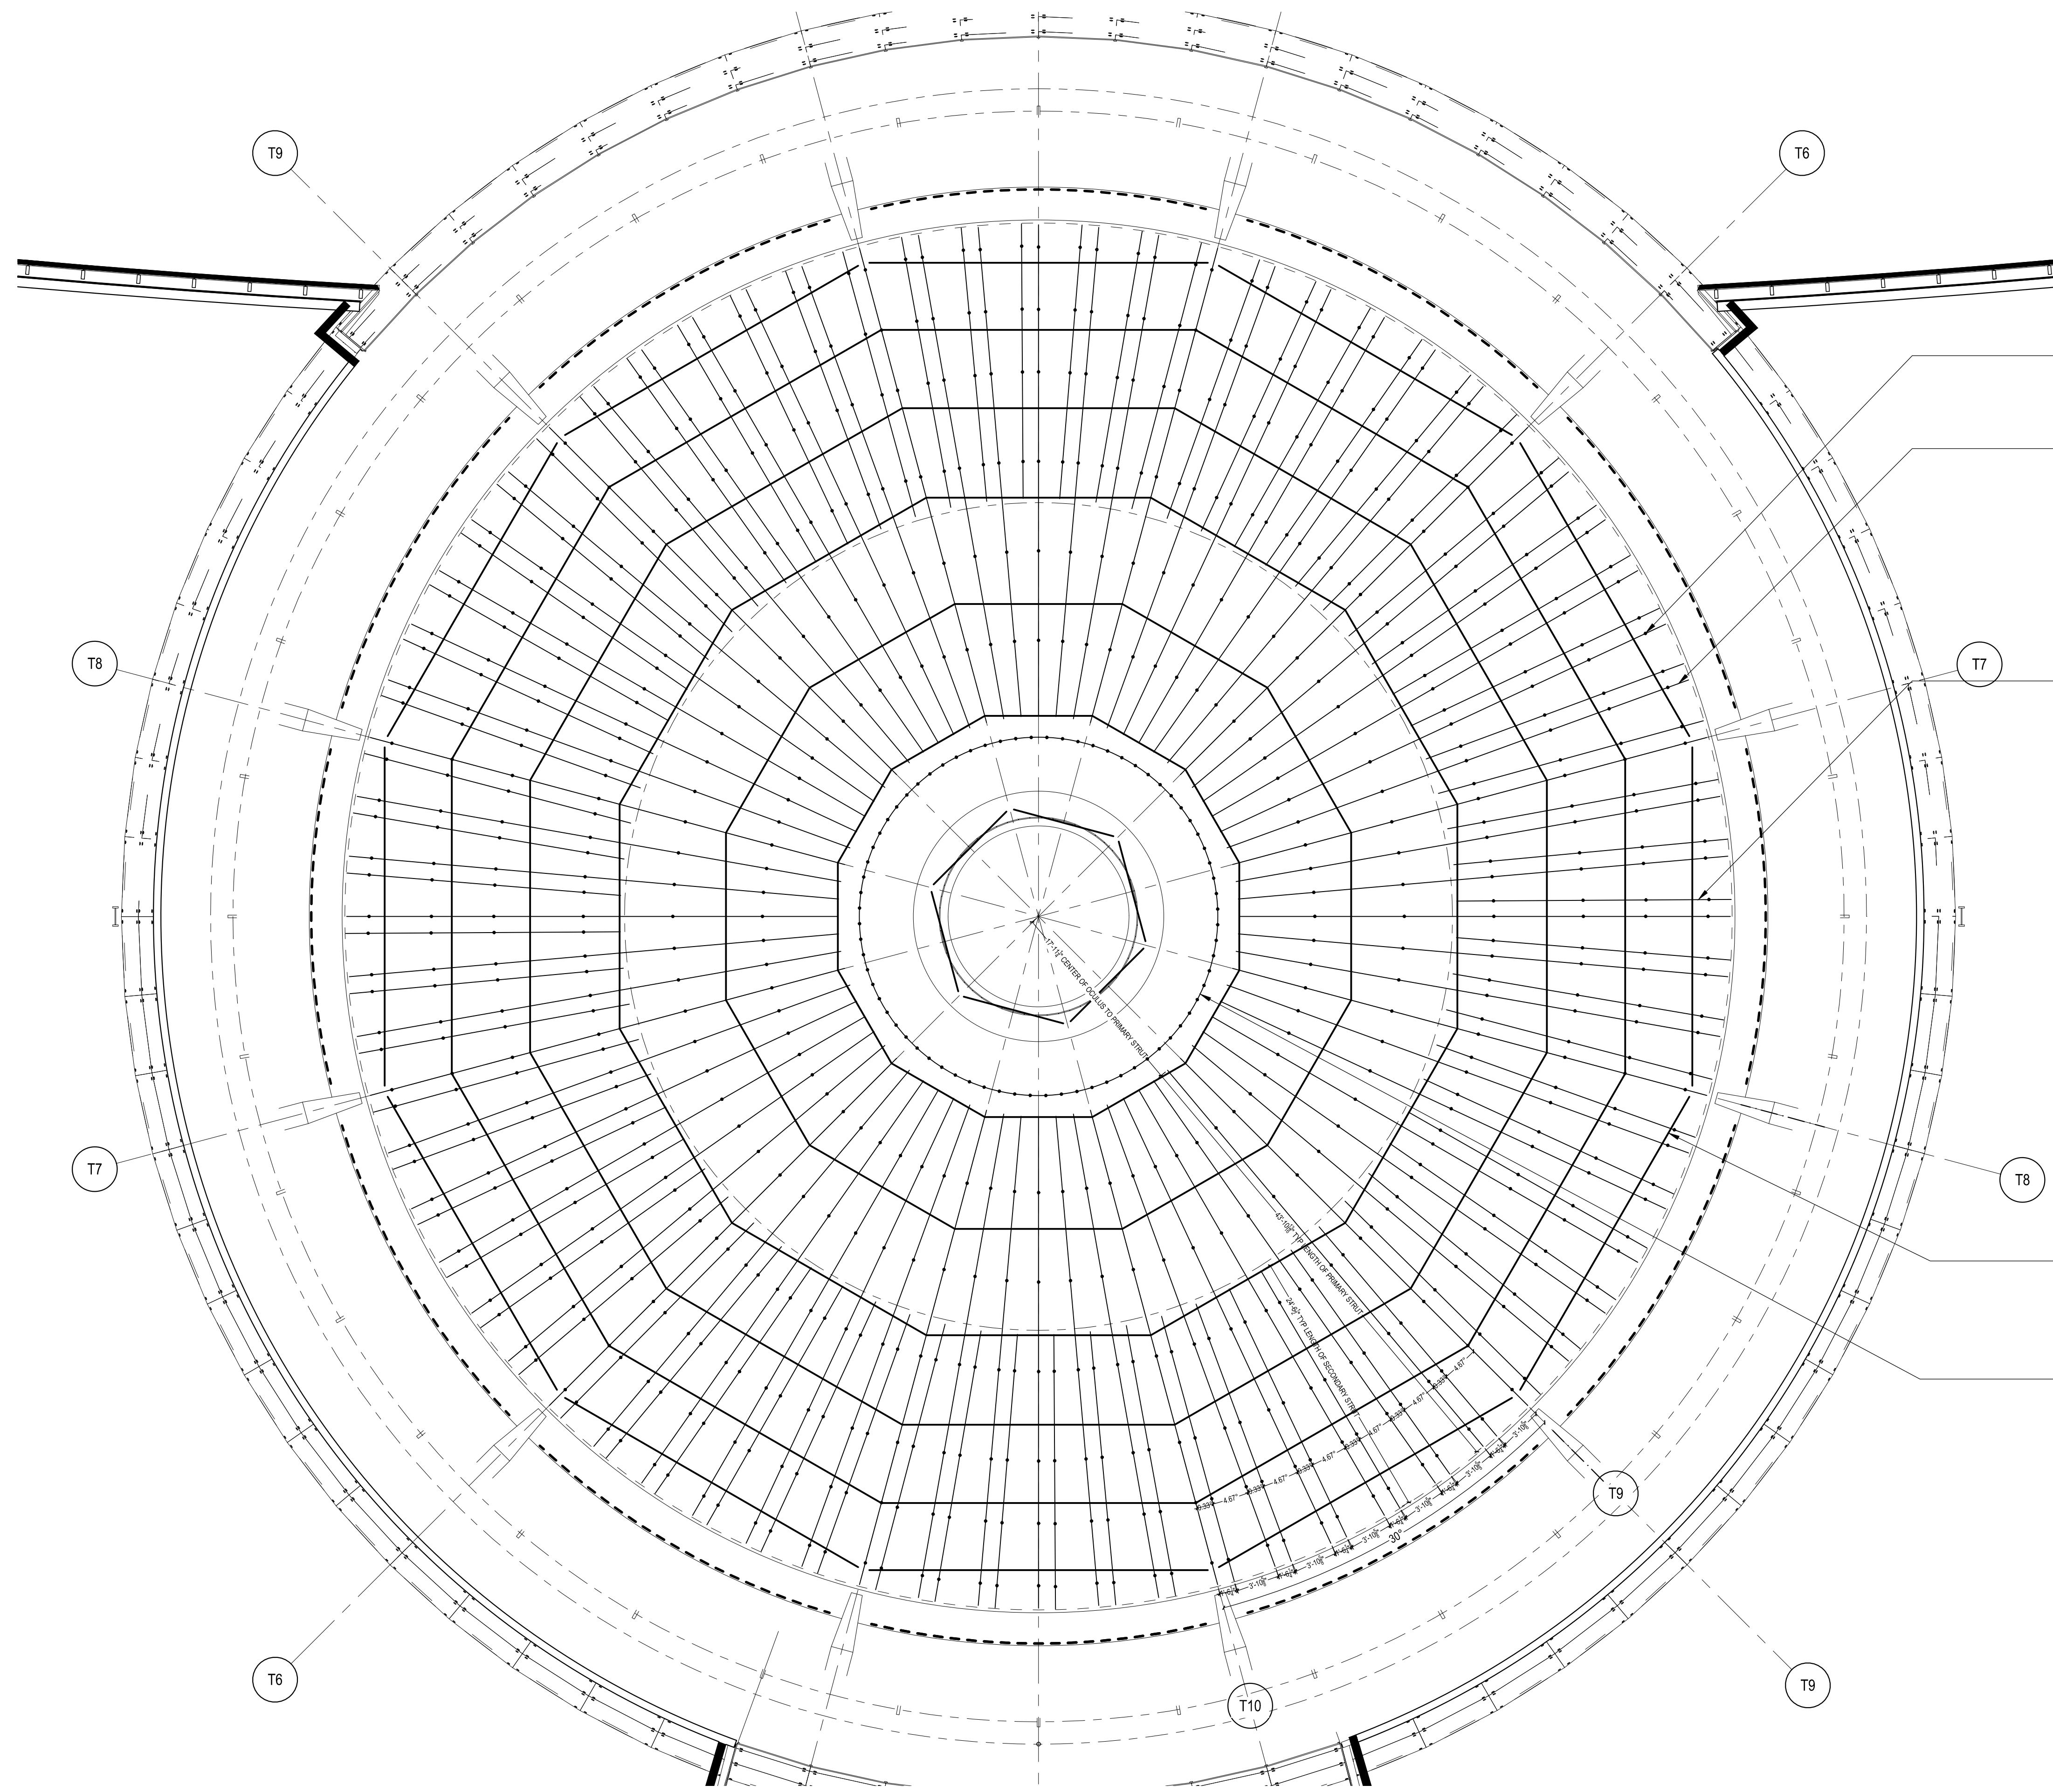

LOCATION OF SUSPENSION CABLES @ 8'-0" O.C.

PRIMARY UNISTRUT ABOVE EACH BLADE
ALIGNED W/ CENTERLINE (BY MAREK BROTHERS)

SECONDARY UNISTRUT ABOVE EACH BLADE
12" IN FROM WIDE EDGE (BY MAREK BROTHERS)

STEEL BEAMS

UNISTRUT RING BELOW CATWALK
4'-4" FROM END OF BLADE (BY MAREK BROTHERS)


1 RCP
SCALE: 1/8" = 1'-0"

- NOTES:**
- 1) ALL DIMENSIONS AND LOCATIONS MUST BE V.I.F. PRIOR TO NEWMAT FABRICATION AND INSTALLATION.
 - 2) ALL DRYWALL APPLICATIONS REQUIRE 12" CONTINUOUS 16GA (MINIMUM) METAL STRAPPING REINFORCEMENT BEHIND DRYWALL AT ALL NEWMAT ATTACHMENT LOCATIONS.
 - 3) ALL "BLOCKING BY OTHERS" MUST BE CONTINUOUS, STRAIGHT, LEVEL AND/OR PLUMB AND ABLE TO WITHSTAND 30LBS. PER LINEAR FOOT OF LATERAL TENSION WHICH WILL BE EXERTED BY EACH LAYER OF MEMBRANE.


AS BUILT
10/3/2019

NOTICE:
THESE DRAWINGS WERE PRODUCED BY AND ARE THE SOLE PROPERTY OF NEWMAT USA LTD ANY AND ALL INFORMATION CONTAINED HEREIN SHALL NOT BE USED BY ANY OTHER PERSON OR COMPANY WITHOUT THE EXPRESSED WRITTEN CONSENT OF NEWMAT USA LTD. THE DRAWINGS MAY HAVE BEEN BASED ON CONSTRUCTION DRAWINGS NOT PREPARED BY NEWMAT USA LTD. THEREFORE MAY NOT REPRESENT THE CONDITIONS AS CONSTRUCTED AT THAT TIME.


NEWMAT NORTHEAST CORP. STRETCH CEILING SYSTEMS	#	REVISIONS:	Drawn	Checked	81 MAHAN STREET, WEST BABYLON, NY 11704 TEL. (631) 261 1498 FAX (631) 261 1756 Drawing Title: ENLARGED RCP Job Title: AMERICAN AIRLINES Customer Name: AMERICAN AIRLINES	Scale:	Drawn By:
	A	2/26/2018	R.K.			AS NOTED	Checked By:
	B	3/1/2018	R.K.			Job Number:	Date:
	C	3/7/2018	R.K.			13-000	2/14/2018
	D	3/15/2018	R.K.			Drawing Number:	
E	5/4/2018	R.K.		A-01.4			

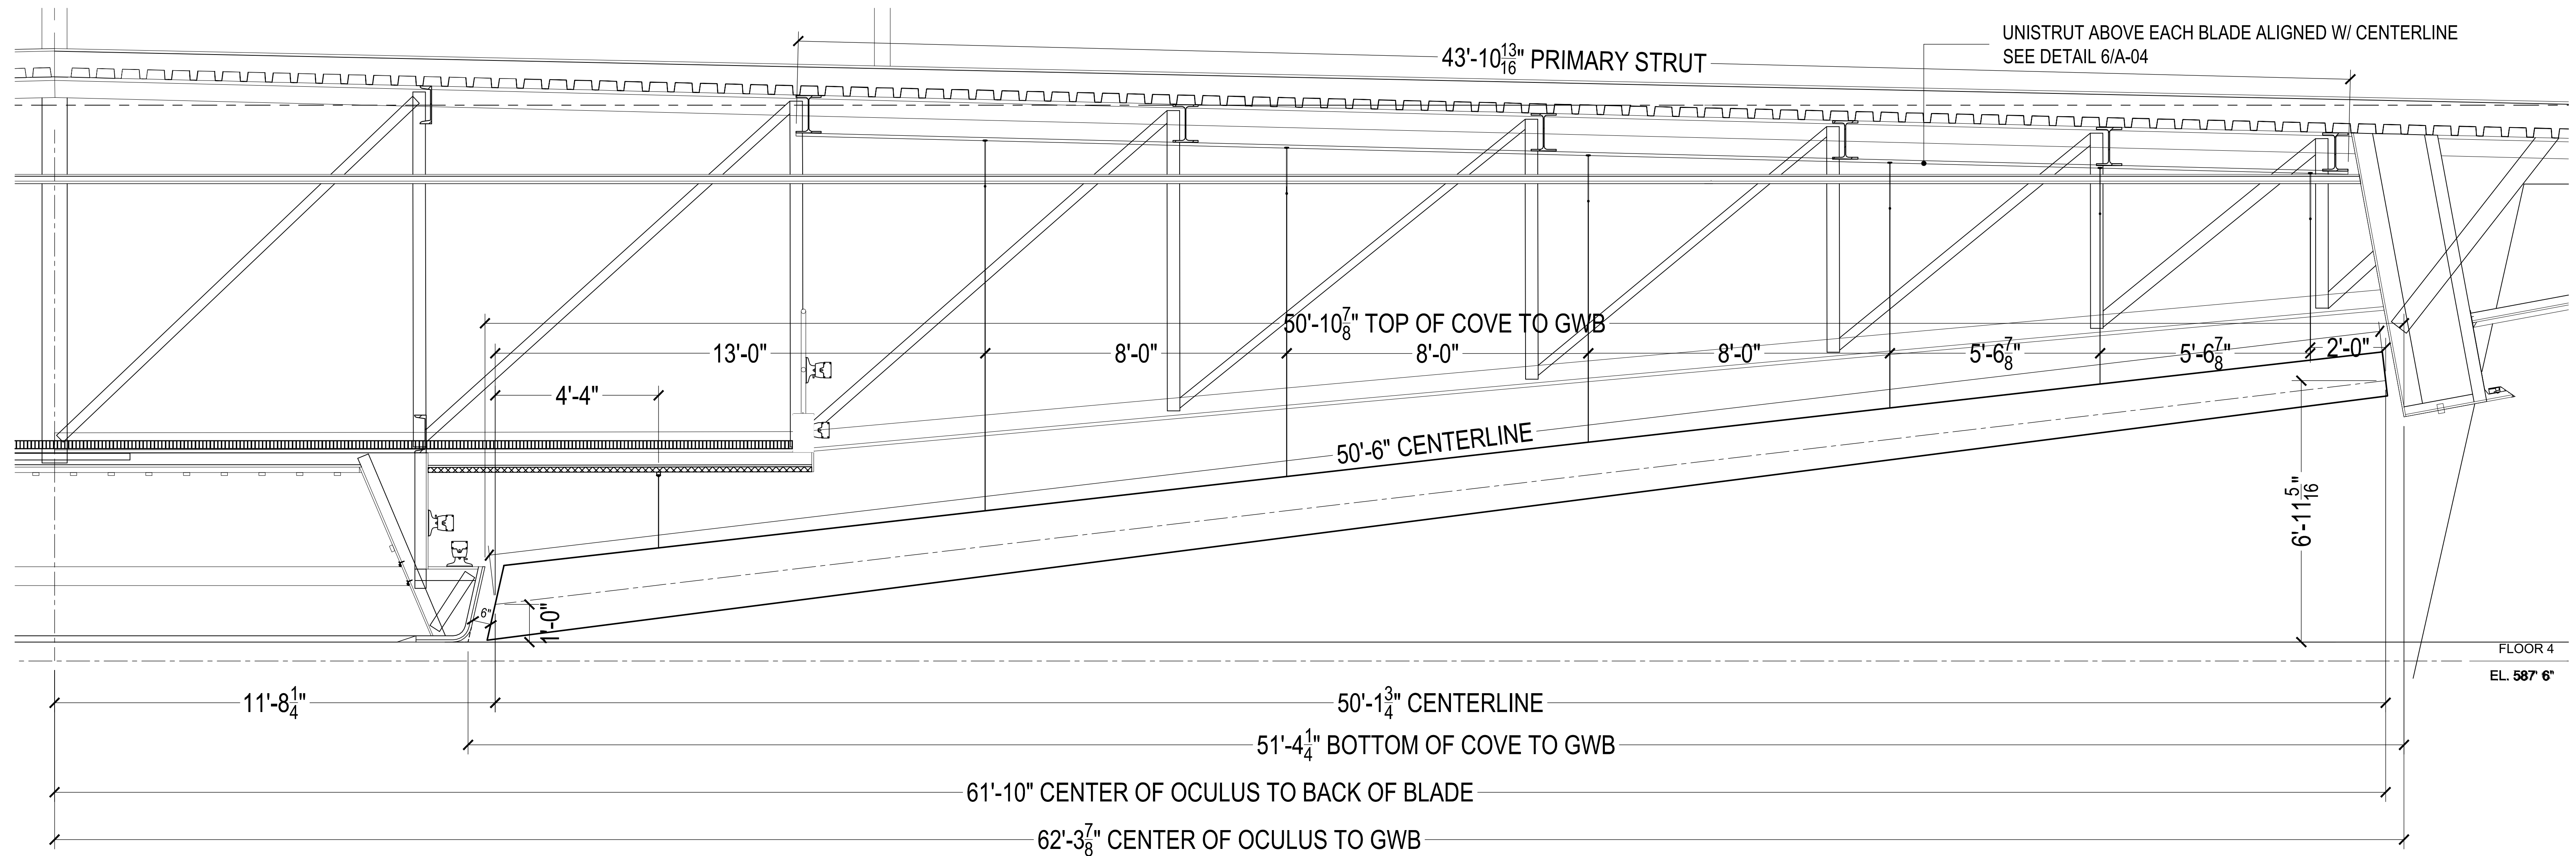

1 SECTION
SCALE: 1/2" = 1'-0"

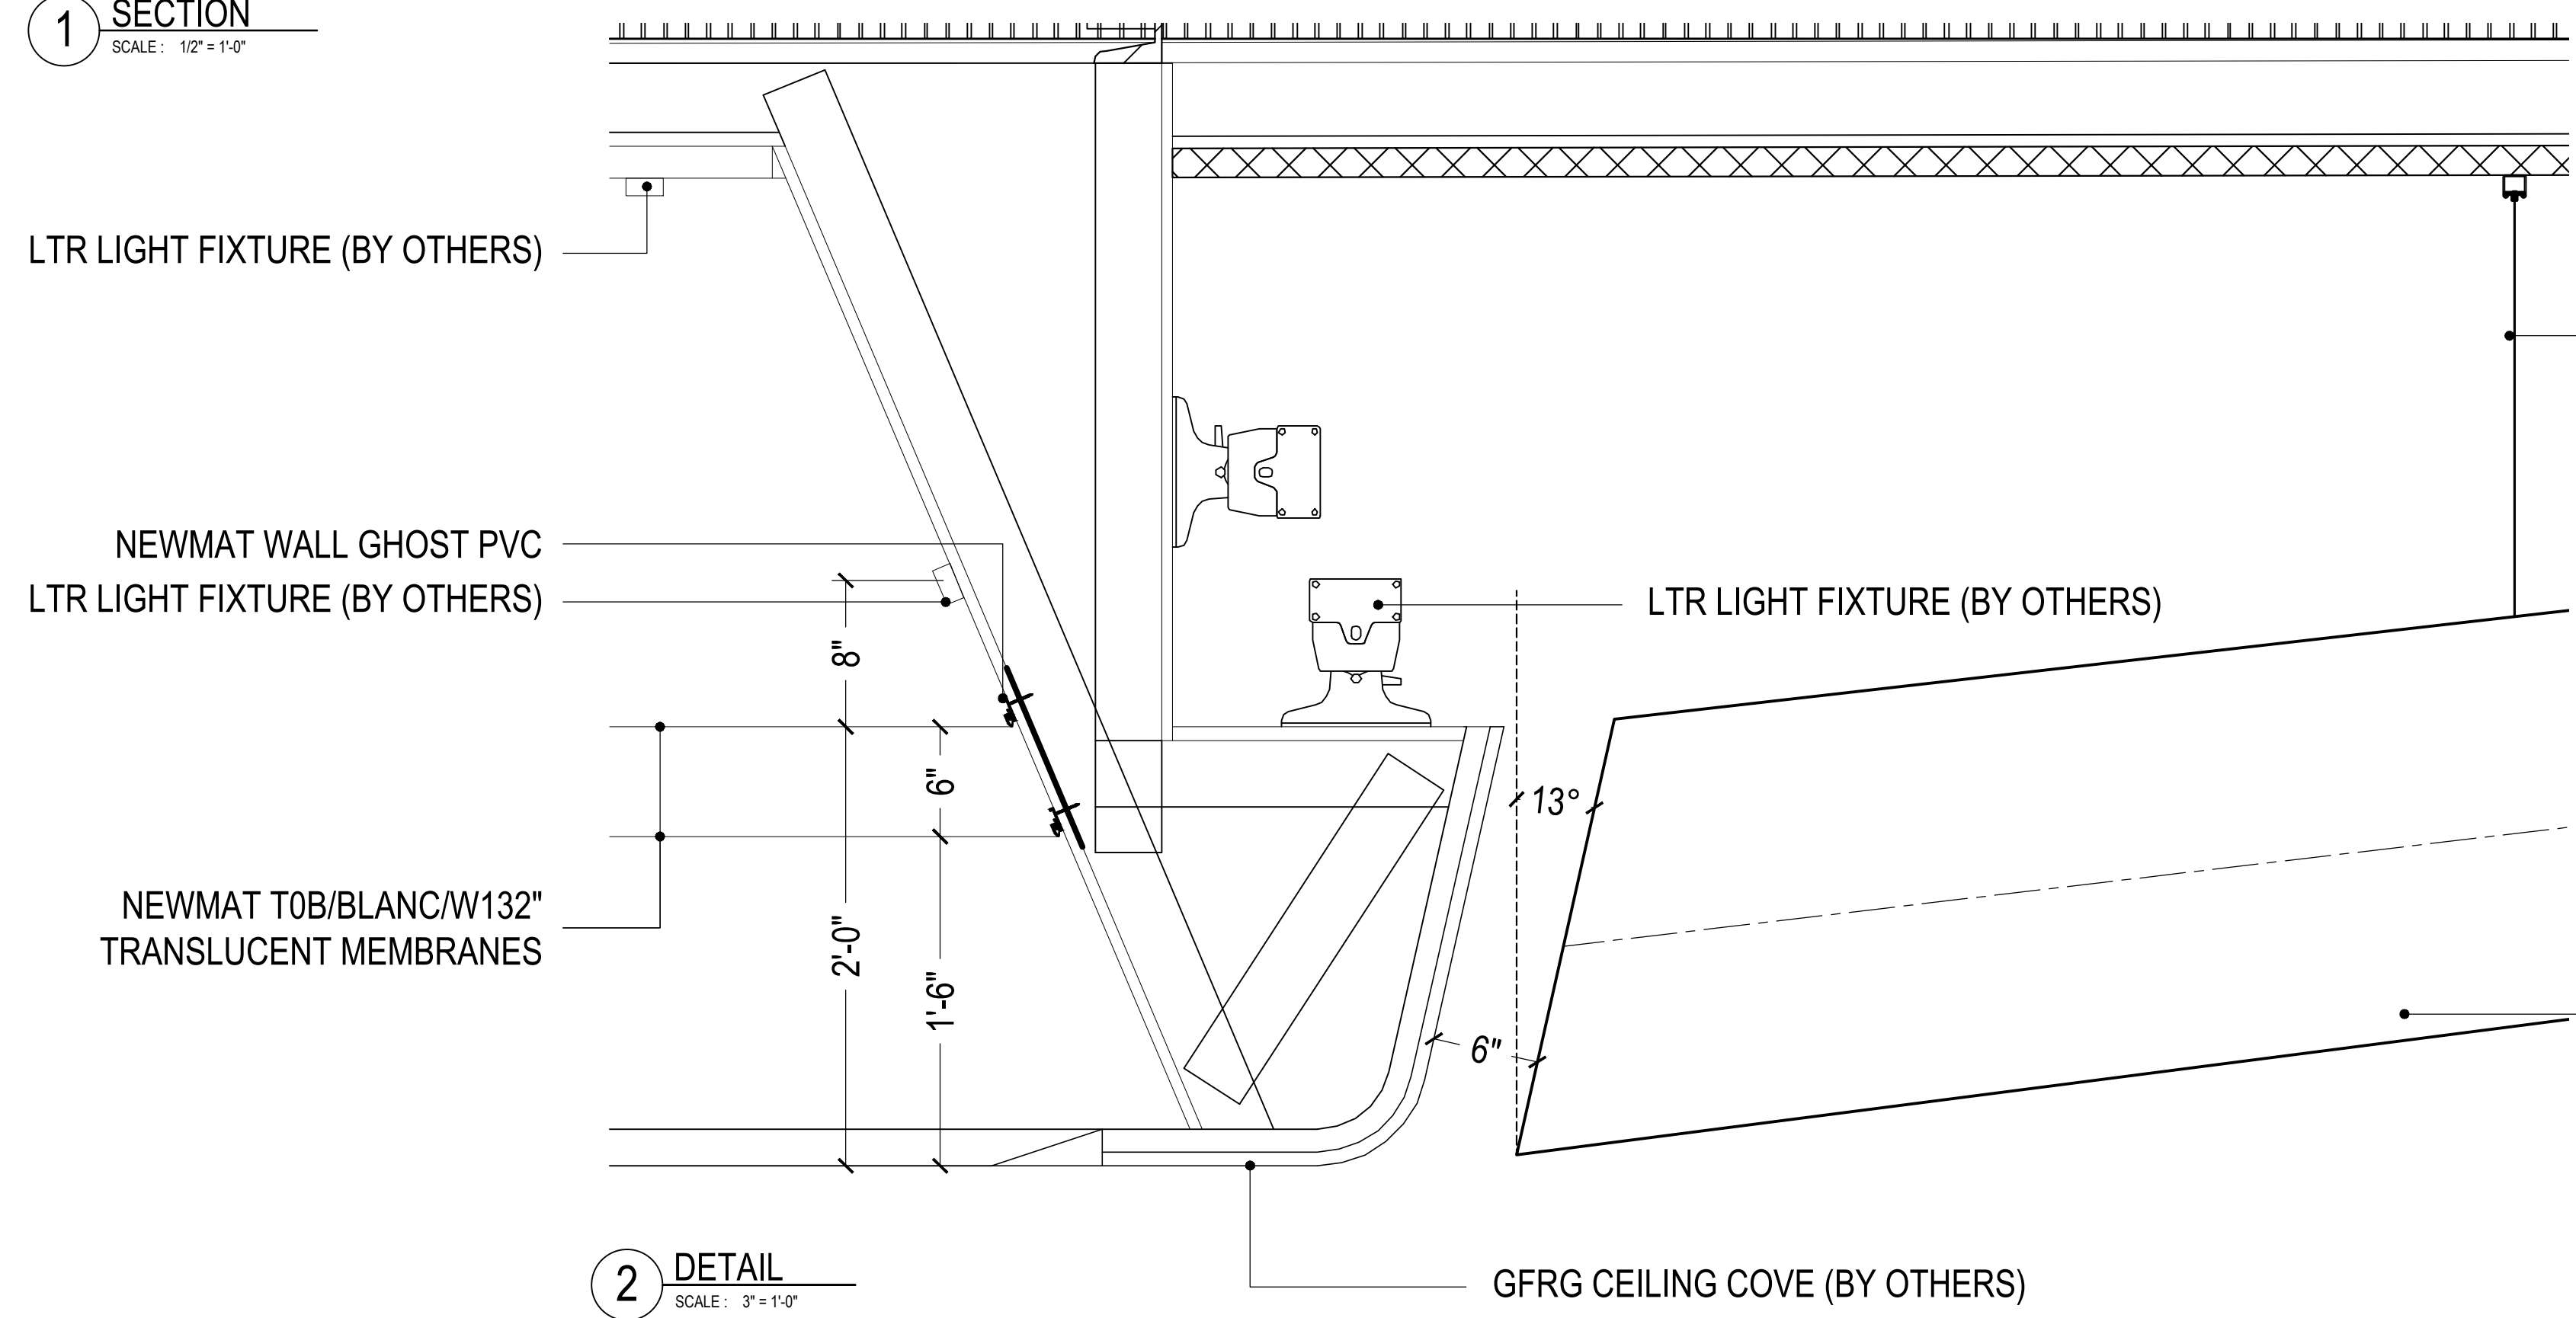

2 DETAIL
SCALE: 3" = 1'-0"

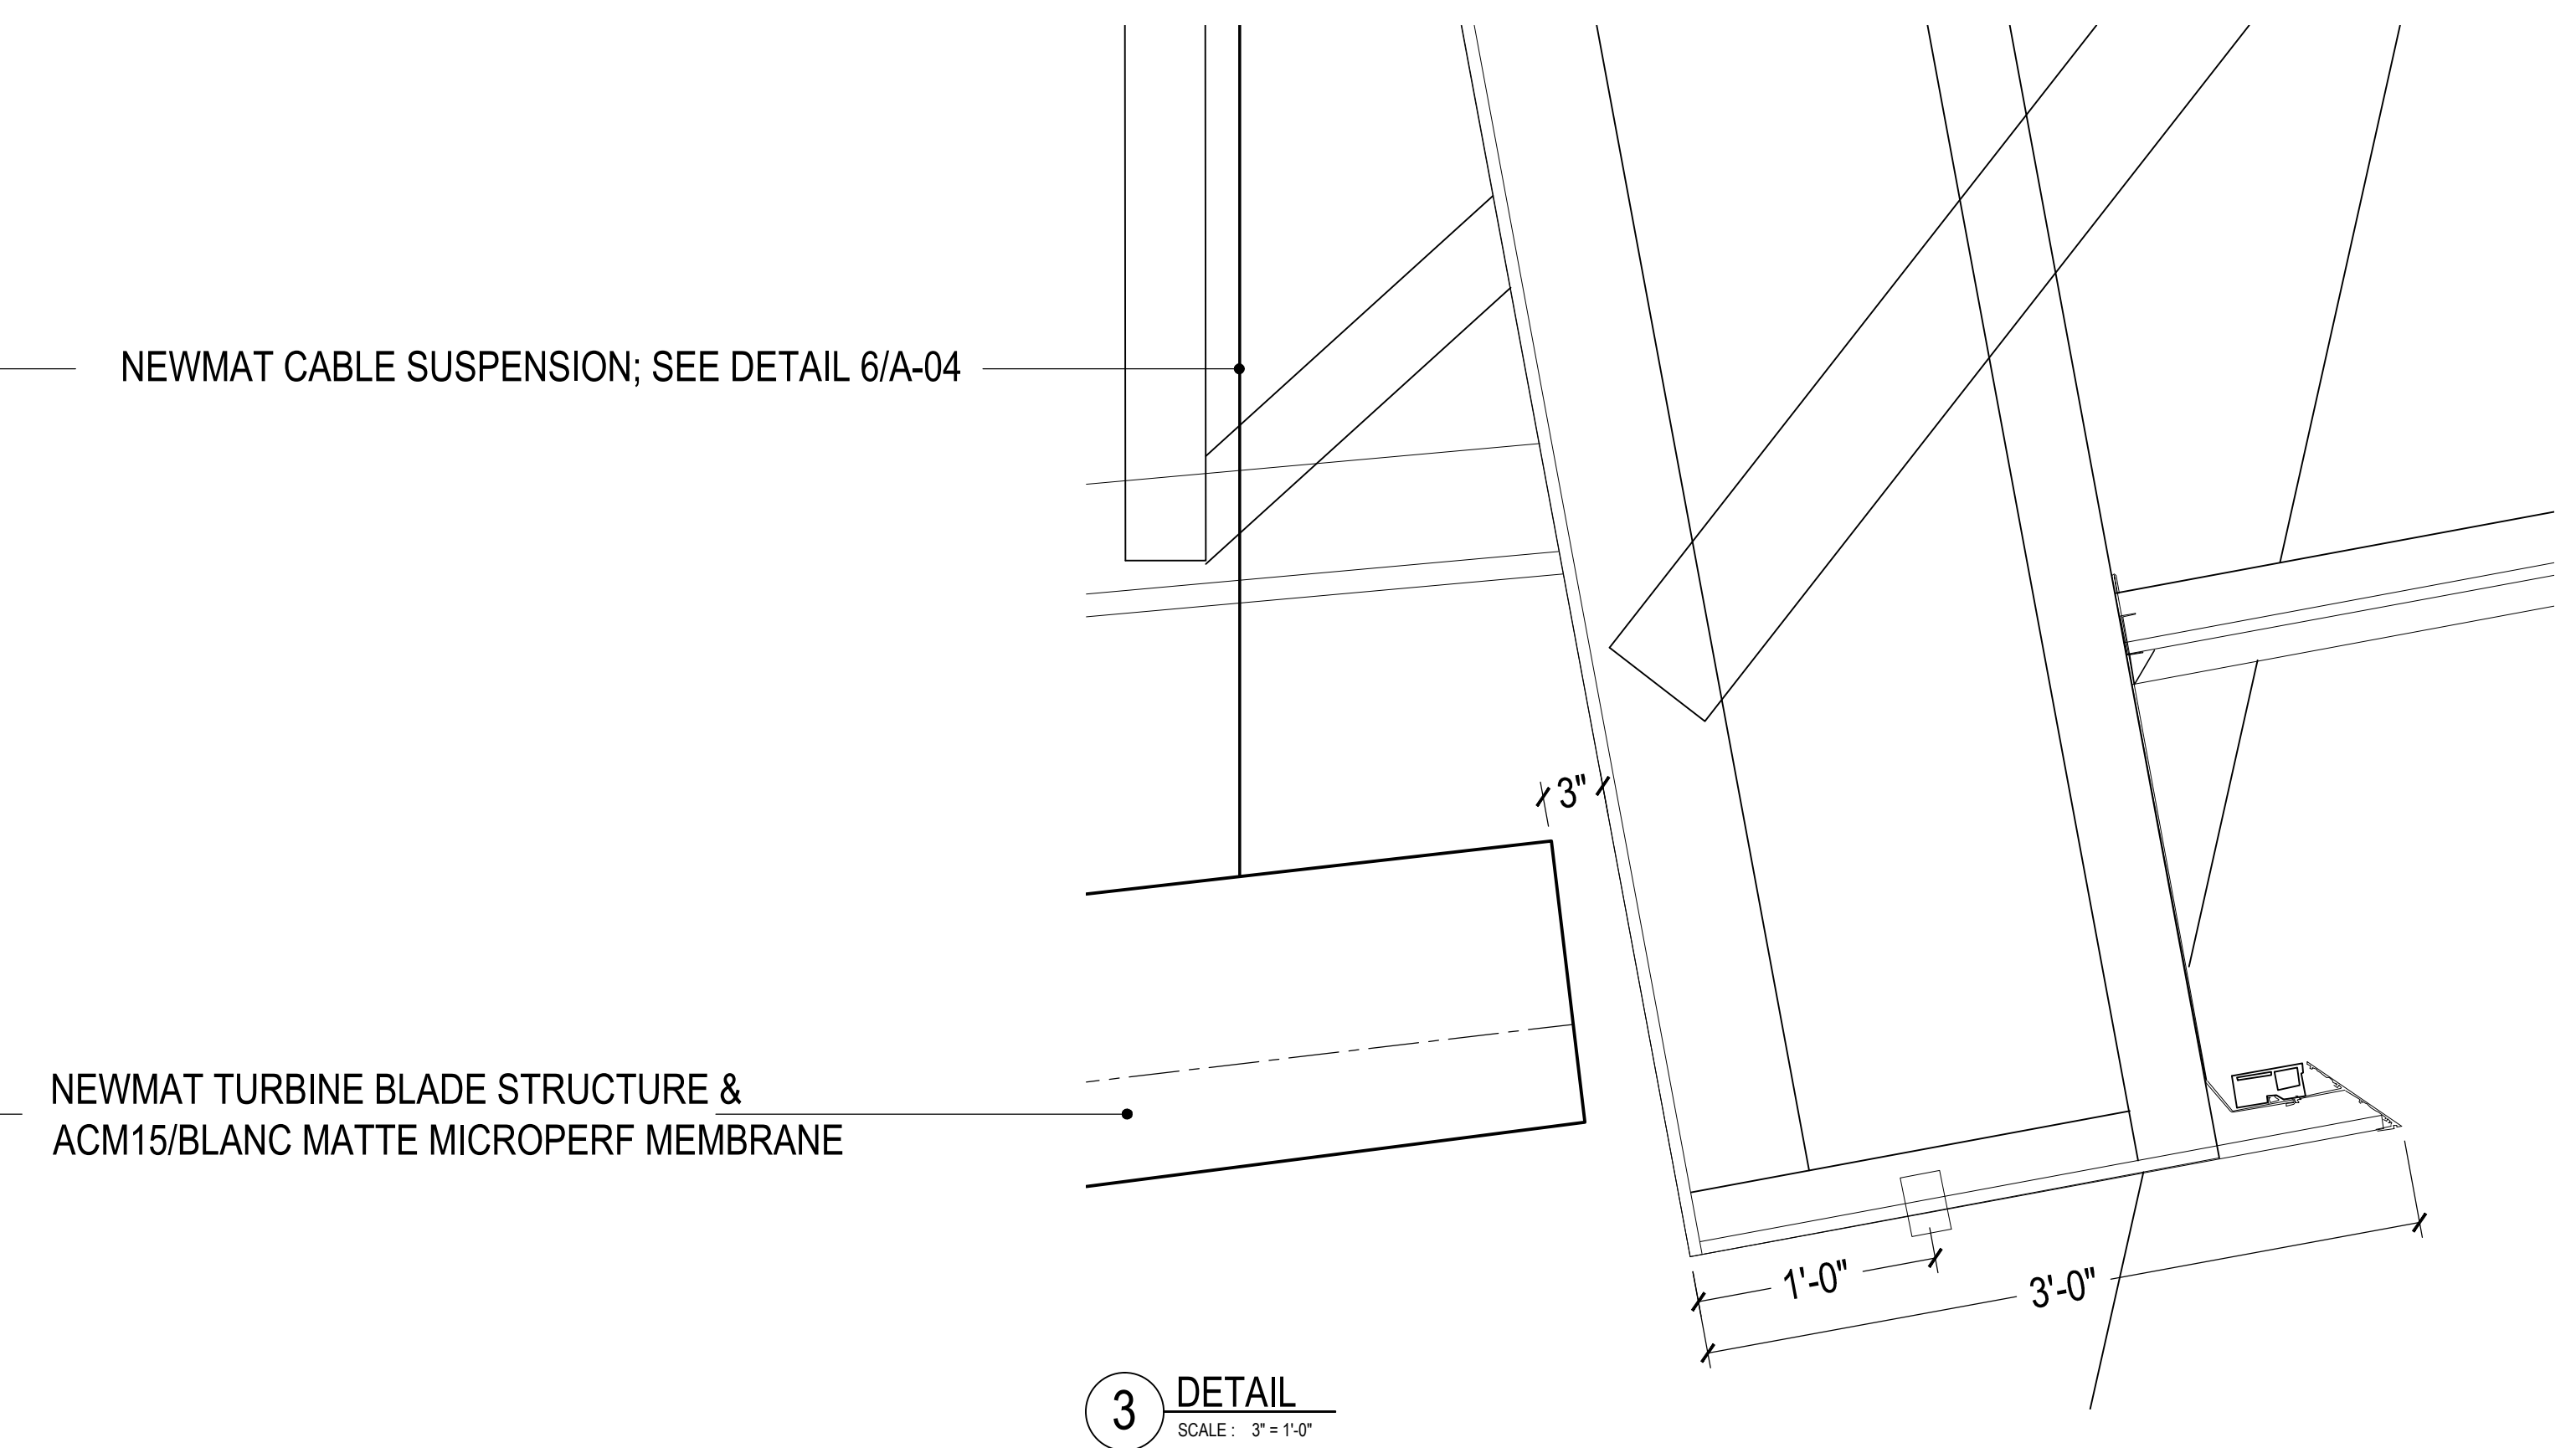

3 DETAIL
SCALE: 3" = 1'-0"




NOTES:
 1) ALL DIMENSIONS AND LOCATIONS MUST BE V.I.F. PRIOR TO NEWMAT FABRICATION AND INSTALLATION.
 2) ALL DRYWALL APPLICATIONS REQUIRE 12" CONTINUOUS 16GA (MINIMUM) METAL STRAPPING REINFORCEMENT BEHIND DRYWALL AT ALL NEWMAT ATTACHMENT LOCATIONS.
 3) ALL "BLOCKING BY OTHERS" MUST BE CONTINUOUS, STRAIGHT, LEVEL AND/OR PLUMB AND ABLE TO WITHSTAND 30LBS. PER LINEAR FOOT OF LATERAL TENSION WHICH WILL BE EXERTED BY EACH LAYER OF MEMBRANE.

APPROX WEIGHT: 835LBS PER BLADE


AS BUILT
10/3/2019

NOTICE:
 THESE DRAWINGS WERE PRODUCED BY AND ARE THE SOLE PROPERTY OF NEWMAT USA LTD ANY AND ALL INFORMATION CONTAINED HEREIN SHALL NOT BE USED BY ANY OTHER PERSON OR COMPANY WITHOUT THE EXPRESSED WRITTEN CONSENT OF NEWMAT USA LTD. THE DRAWINGS MAY HAVE BEEN BASED ON CONSTRUCTION DRAWINGS NOT PREPARED BY NEWMAT USA LTD. THEREFORE MAY NOT REPRESENT THE CONDITIONS AS CONSTRUCTED AT THAT TIME.

NEWMAT NORTHEAST CORP. 	#	REVISIONS:	Drawn	Checked	81 MAHAN STREET, WEST BABYLON, NY 11704 TEL: (631) 261 1498 FAX: (631) 261 1756 SECTION Job Title: AMERICAN AIRLINES Customer Name: AMERICAN AIRLINES TRINITY COMPLEX FORT WORTH, TX	Scale:	Drawn By:
	A	2/26/2018	R.K.			AS NOTED	R.K.
	B	3/1/2018	R.K.				Checked By:
	C	3/7/2018	R.K.				Job Number:
	D	3/15/2018	R.K.				Date:
E	6/18/2018	R.K.			13-000	2/14/2018	
					Drawing Number:		
						A-02	

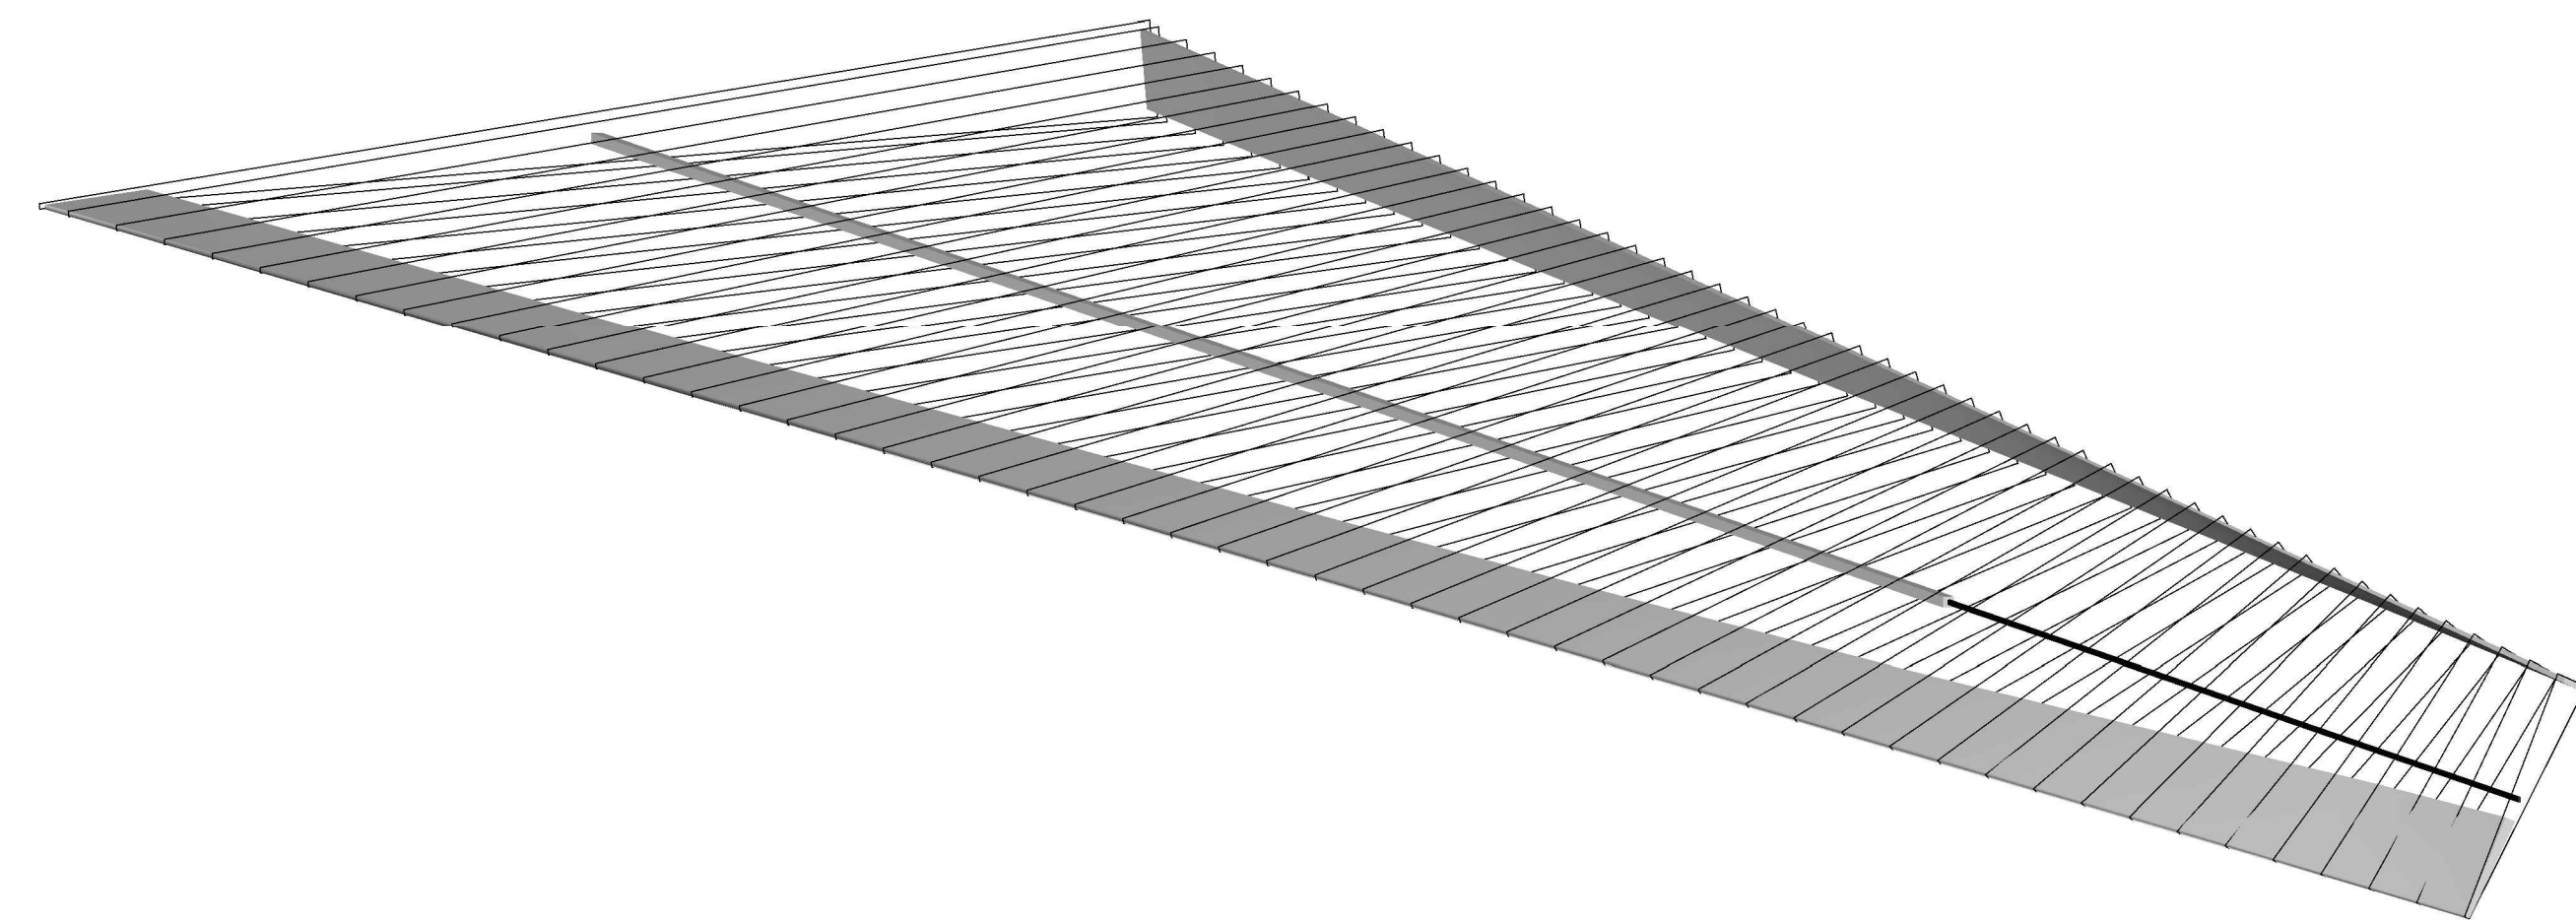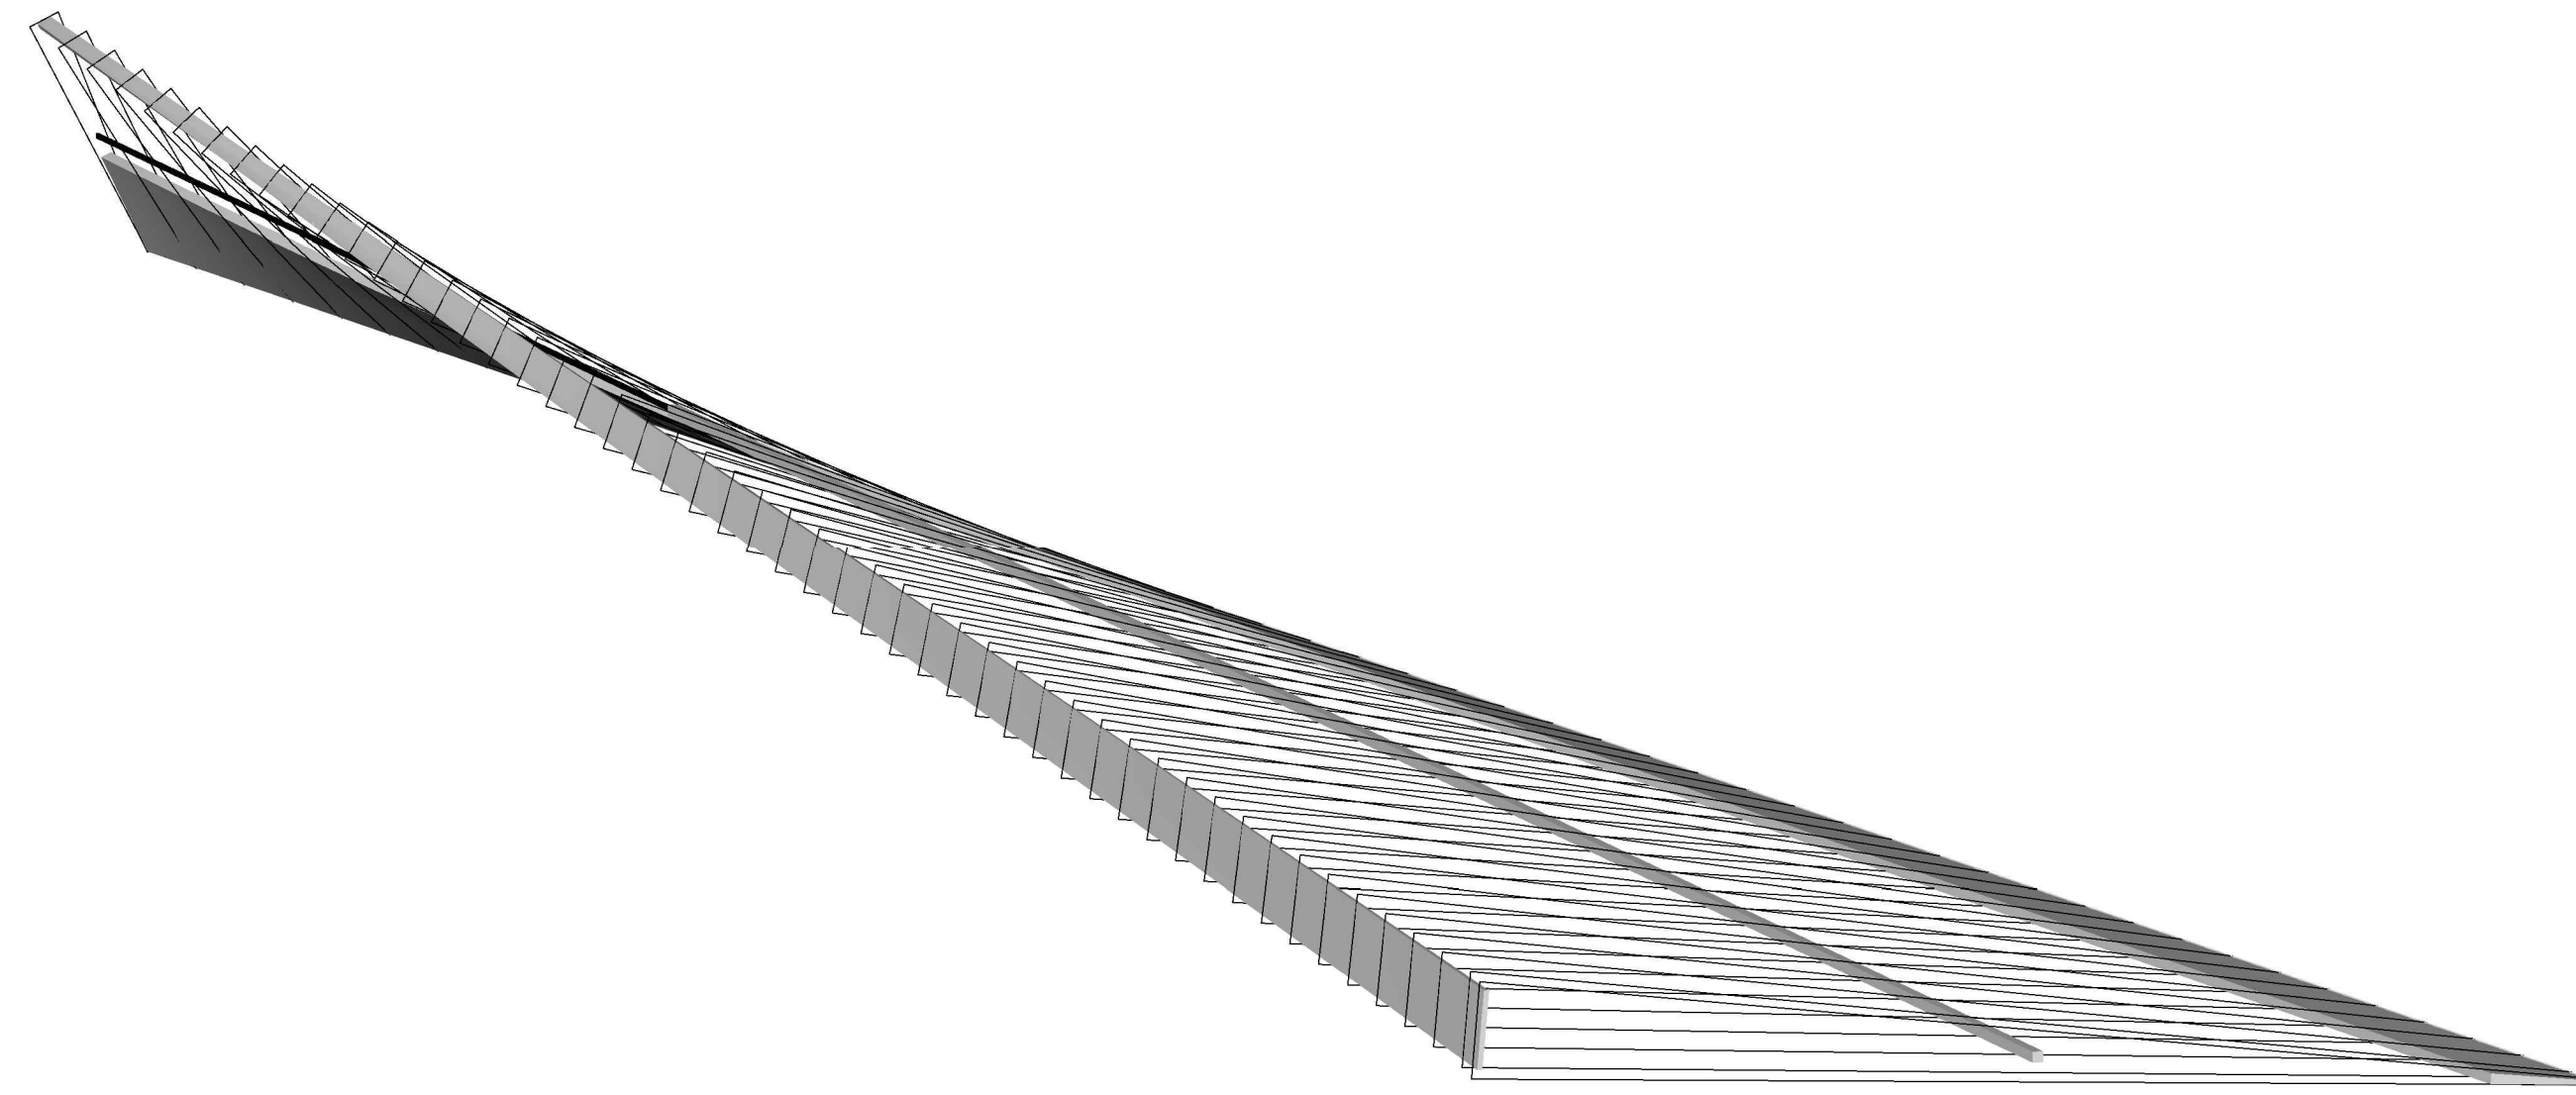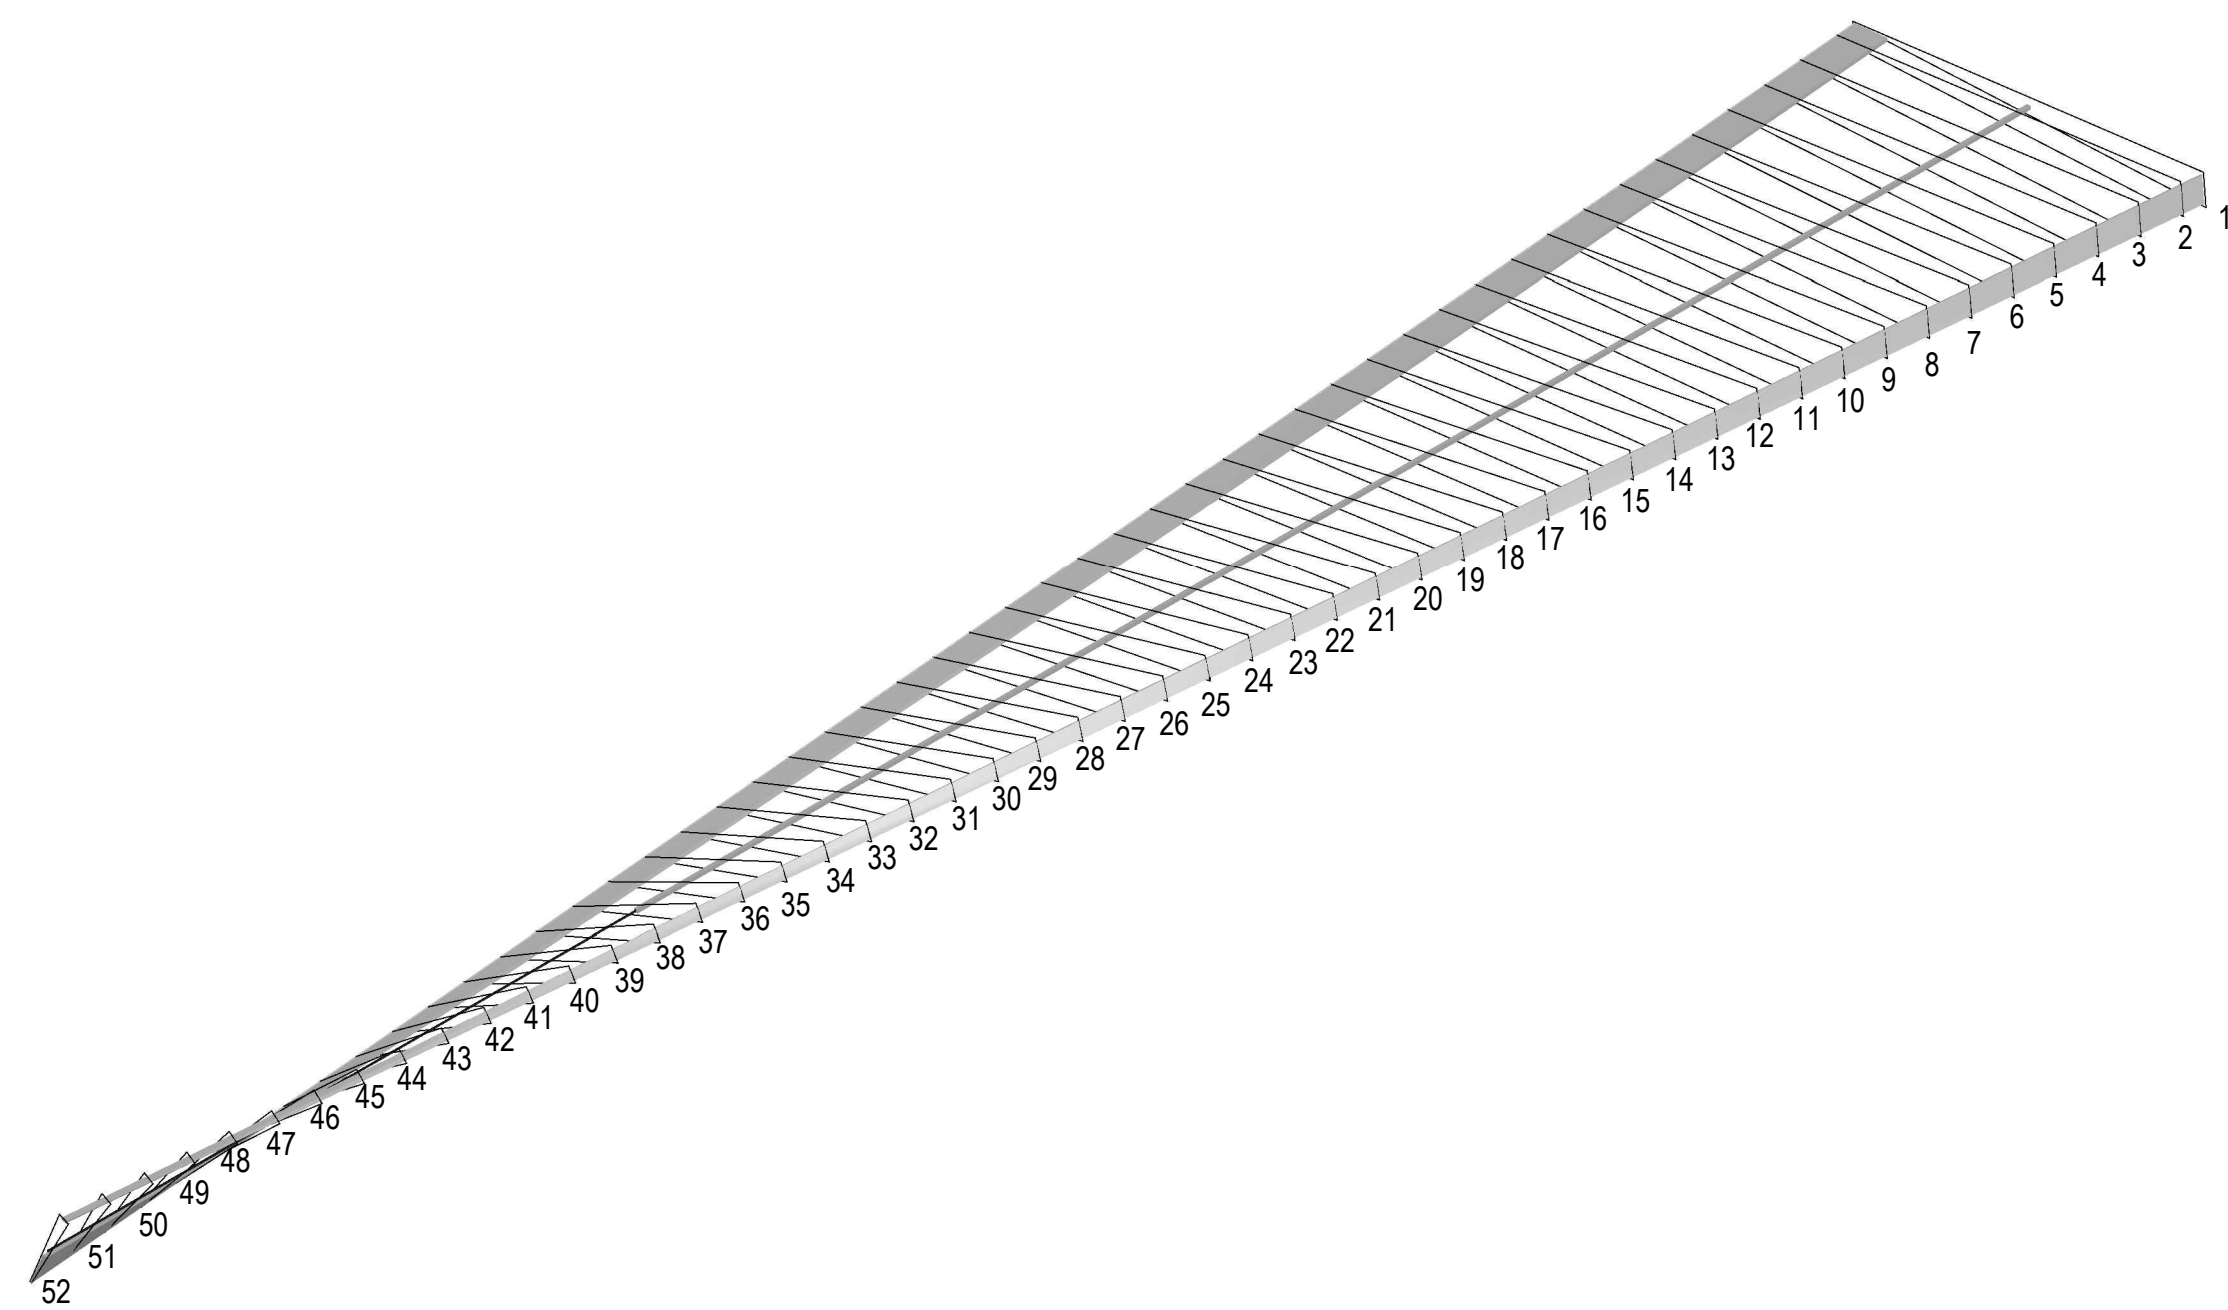

RIB #	POSITION	ANGLE (°)	LENGTH (")	TOP WIDTH (")
1	0'	84.89	107.06	8.94
2	0.5'	84.78	106.12	8.88
3	1.5'	84.56	104.24	8.76
4	2.5'	84.33	102.36	8.64
5	3.5'	84.09	100.49	8.53
6	4.5'	83.84	98.61	8.41
7	5.5'	83.58	96.74	8.29
8	6.5'	83.31	94.87	8.17
9	7.5'	83.02	93.01	8.06
10	8.5'	82.73	91.14	7.94
11	9.5'	82.43	89.28	7.82
12	10.5'	82.11	87.42	7.7
13	11.5'	81.78	85.56	7.59
14	12.5'	81.43	83.71	7.47
15	13.5'	81.07	81.86	7.36
16	14.5'	80.69	80.01	7.24
17	15.5'	80.29	78.16	7.13
18	16.5'	79.88	76.32	7.01
19	17.5'	79.44	74.49	6.9
20	18.5'	78.98	72.66	6.78
21	19.5'	78.5	70.83	6.67
22	20.5'	78	69.01	6.56
23	21.5'	77.46	67.19	6.44
24	22.5'	76.9	65.39	6.33
25	23.5'	76.3	63.59	6.22
26	24.5'	75.67	61.79	6.11
27	25.5'	75	60	6
28	26.5'	74.28	58.22	5.84
29	27.5'	73.51	56.45	5.68
30	28.5'	72.69	54.7	5.52
31	29.5'	71.82	52.95	5.36
32	30.5'	70.88	51.22	5.21
33	31.5'	69.89	49.5	5.05
34	32.5'	68.82	47.8	4.9
35	33.5'	67.67	46.11	4.75
36	34.5'	66.44	44.45	4.61
37	35.5'	65.11	42.81	4.47
38	36.5'	63.67	41.19	4.33
39	37.5'	62.12	39.6	4.19
40	38.5'	60.45	38.04	4.06
41	39.5'	58.63	36.52	3.94
42	40.5'	56.65	35.04	3.81
43	41.5'	54.5	33.6	3.7
44	42.5'	52.17	32.22	3.59
45	43.5'	49.62	30.89	3.49
46	44.5'	46.86	29.63	3.39
47	45.5'	43.86	28.44	3.3
48	46.5'	40.6	27.34	3.22
49	47.5'	37.09	26.33	3.15
50	48.5'	33.31	25.43	3.09
51	49.5'	29.28	24.65	3.04
52	50.5'	25	25.35	3.02

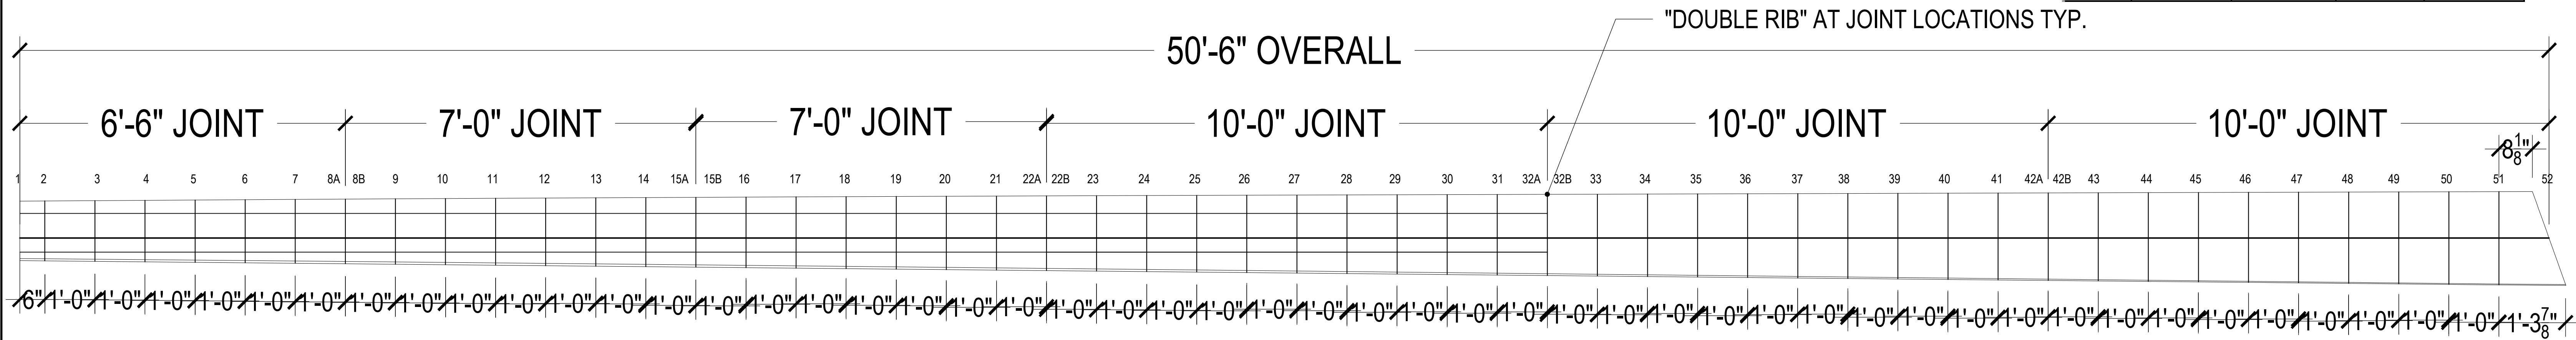


1 VIEWS OF TYP TURBINE RIBS
SCALE: NTS

NOTES:
 1) ALL DIMENSIONS AND LOCATIONS MUST BE V.I.F. PRIOR TO NEWMAT FABRICATION AND INSTALLATION.
 2) ALL DRYWALL APPLICATIONS REQUIRE 12" CONTINUOUS 16GA (MINIMUM) METAL STRAPPING REINFORCEMENT BEHIND DRYWALL AT ALL NEWMAT ATTACHMENT LOCATIONS.
 3) ALL "BLOCKING BY OTHERS", MUST BE CONTINUOUS, STRAIGHT, LEVEL AND/OR PLUMB AND ABLE TO WITHSTAND 30LBS. PER LINEAR FOOT OF LATERAL TENSION WHICH WILL BE EXERTED BY EACH LAYER OF MEMBRANE.

AS BUILT
10/3/2019

NOTICE:
 THESE DRAWINGS WERE PRODUCED BY AND ARE THE SOLE PROPERTY OF NEWMAT USA LTD AND ALL INFORMATION CONTAINED HEREIN SHALL NOT BE USED BY ANY OTHER PERSON OR COMPANY WITHOUT THE EXPRESSED WRITTEN CONSENT OF NEWMAT USA LTD. THE DRAWINGS MAY HAVE BEEN BASED ON CONSTRUCTION DRAWINGS NOT PREPARED BY NEWMAT USA LTD. THEREFORE MAY NOT REPRESENT THE CONDITIONS AS CONSTRUCTED AT THAT TIME.

NEWMAT NORTHEAST CORP. STRETCH CEILING SYSTEMS	#	DATE	Drawn By	Checked By	81 MAHAN STREET, WEST BABYLON, NY 11704 TEL: (631) 261 1498 FAX: (631) 261 1756 Drawing Title: RIBS Job Title: AMERICAN AIRLINES Customer Name: AMERICAN AIRLINES	Scale:	Drawn By:	
	A	2/26/2018	R.K.			AS NOTED	R.K.	
	B	3/1/2018	R.K.				Checked By:	
	C	3/7/2018	R.K.				Job Number: 13-000	Date: 2/14/2018
	D	3/15/2018	R.K.				Drawing Number: A-03	
E	5/4/2018	R.K.						

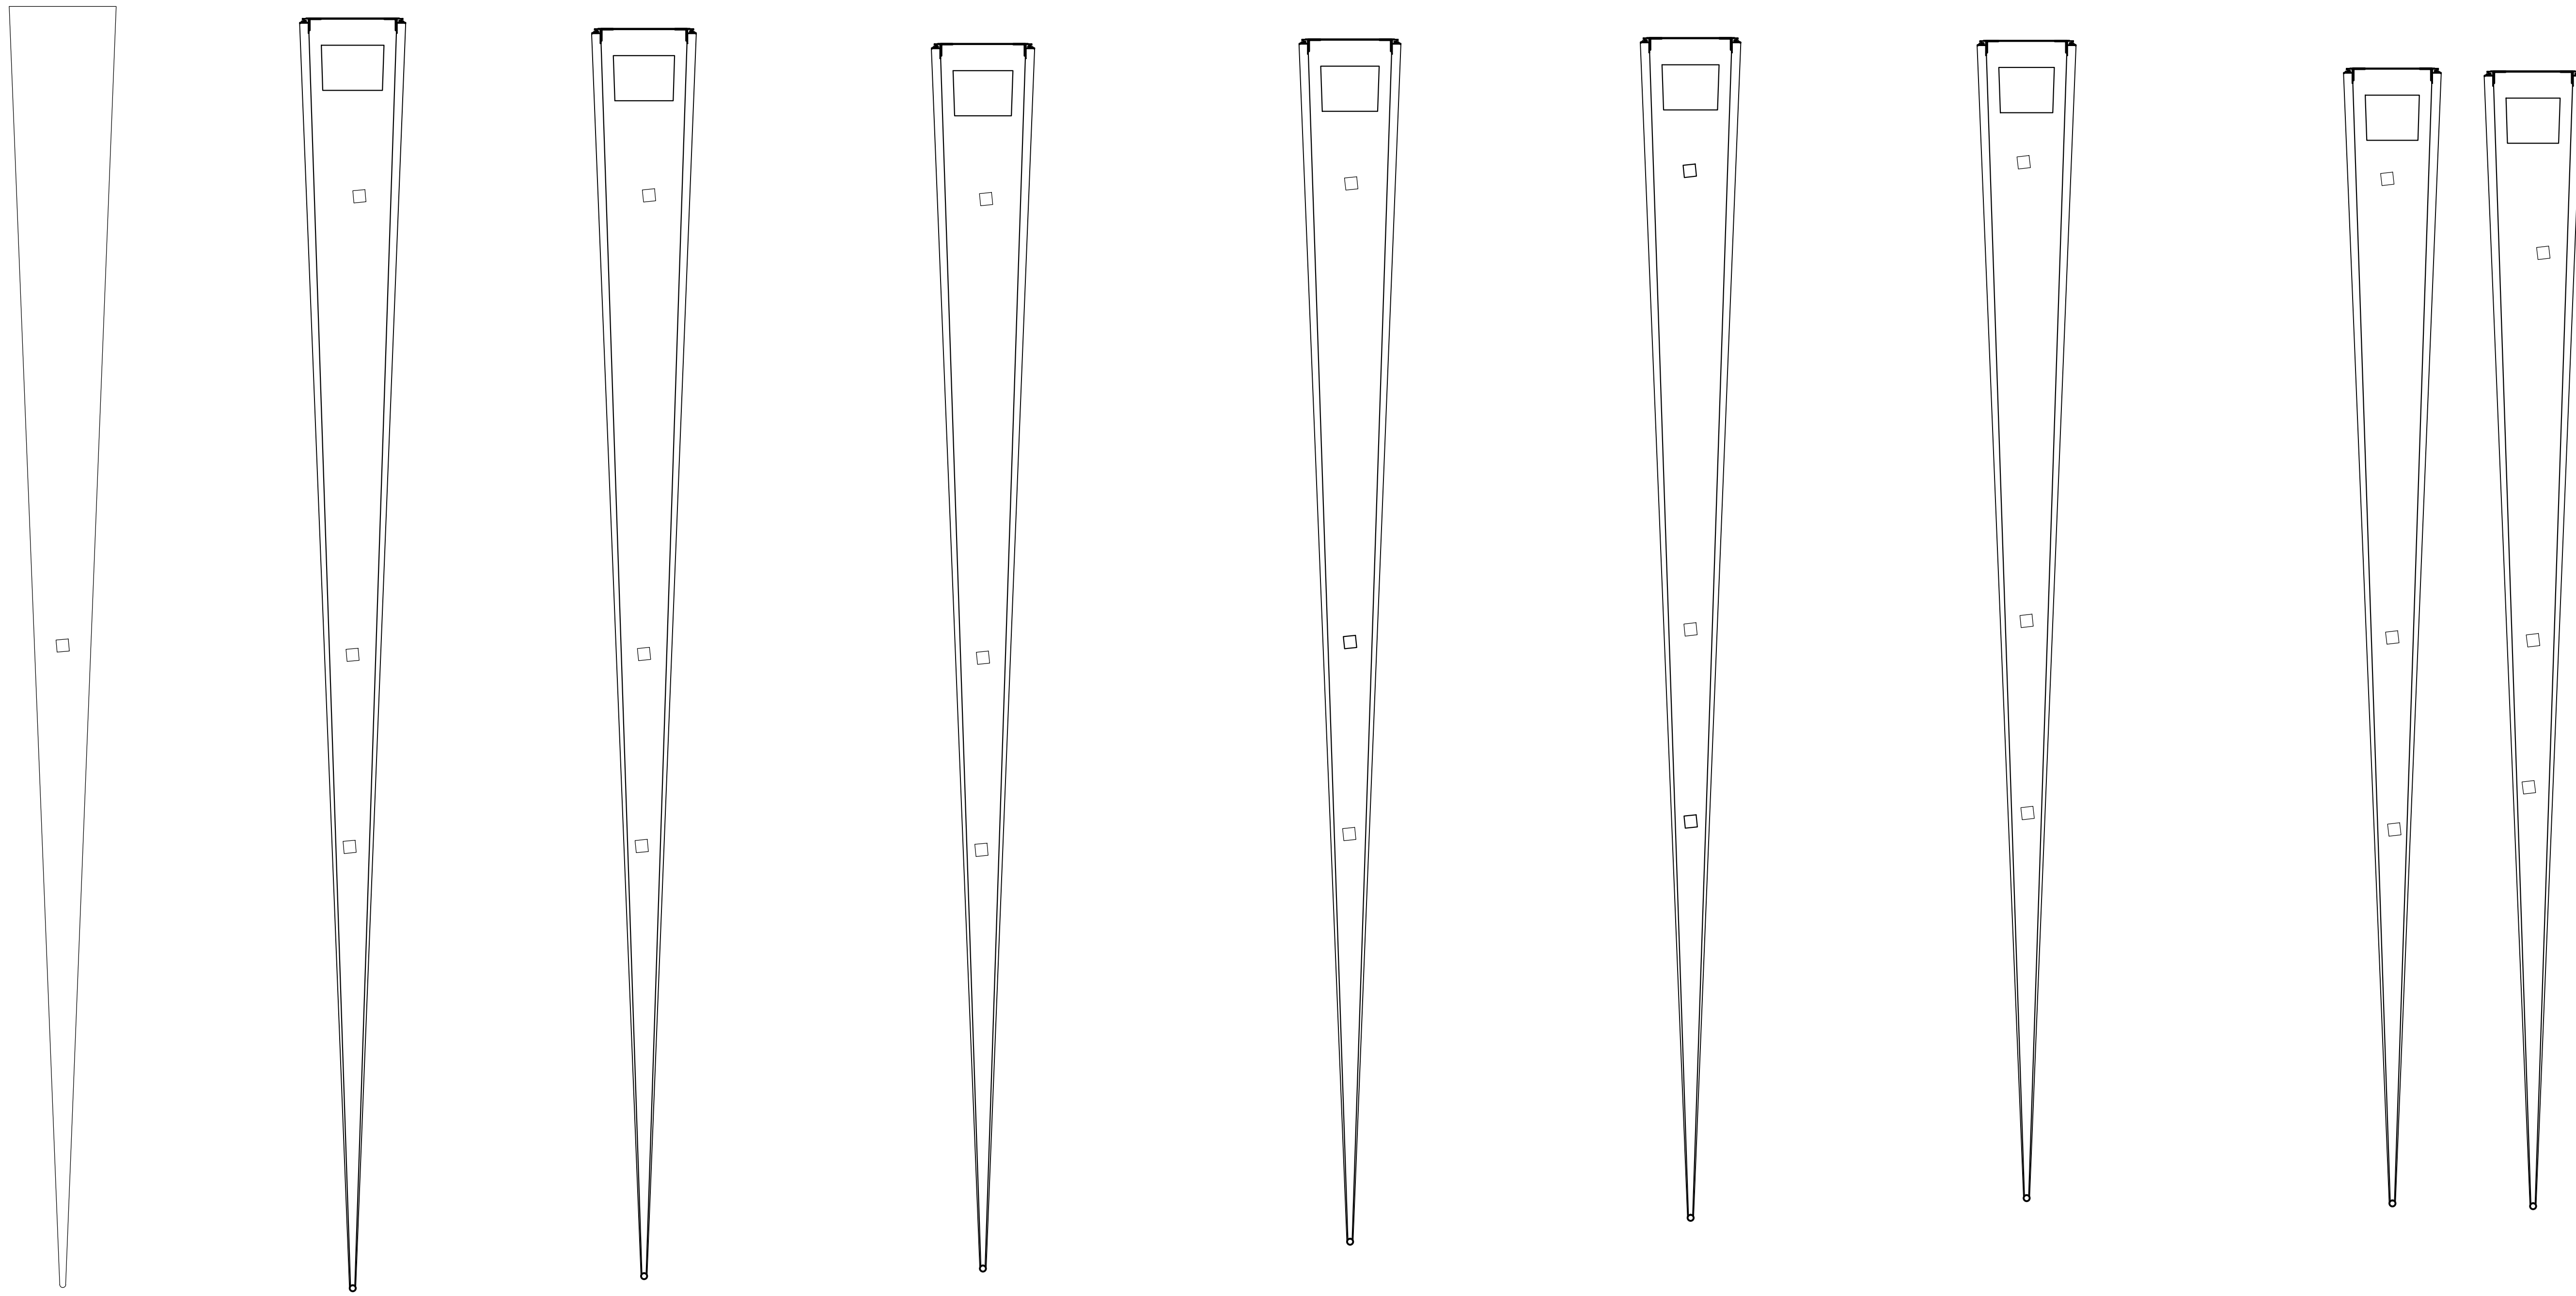

1 VIEW @ END CAP/RIB #1
SCALE: 1 1/2"=1'-0"

2 DETAIL @ RIB #2
SCALE: 1 1/2"=1'-0"

3 DETAIL @ RIB #3
SCALE: 1 1/2"=1'-0"

4 DETAIL @ RIB #4
SCALE: 1 1/2"=1'-0"

5 DETAIL @ RIB #5
SCALE: 1 1/2"=1'-0"

6 DETAIL @ RIB #6
SCALE: 1 1/2"=1'-0"

7 DETAIL @ RIB #7
SCALE: 1 1/2"=1'-0"


8 DETAIL @ RIB #8A&B
SCALE: 1 1/2"=1'-0"

NOTES:
 1) ALL DIMENSIONS AND LOCATIONS MUST BE V.I.F. PRIOR TO NEWMAT FABRICATION AND INSTALLATION.
 2) ALL DRYWALL APPLICATIONS REQUIRE 12" CONTINUOUS 16GA (MINIMUM) METAL STRAPPING REINFORCEMENT BEHIND DRYWALL AT ALL NEWMAT ATTACHMENT LOCATIONS.
 3) ALL "BLOCKING BY OTHERS", MUST BE CONTINUOUS, STRAIGHT, LEVEL AND/OR PLUMB AND ABLE TO WITHSTAND 30LBS. PER LINEAR FOOT OF LATERAL TENSION WHICH WILL BE EXERTED BY EACH LAYER OF MEMBRANE.

AS BUILT
10/3/2019

NOTICE:
 THESE DRAWINGS WERE PRODUCED BY AND ARE THE SOLE PROPERTY OF NEWMAT USA LTD AND ALL INFORMATION CONTAINED HEREIN SHALL NOT BE USED BY ANY OTHER PERSON OR COMPANY WITHOUT THE EXPRESSED WRITTEN CONSENT OF NEWMAT USA LTD. THE DRAWINGS MAY HAVE BEEN BASED ON CONSTRUCTION DRAWINGS NOT PREPARED BY NEWMAT USA LTD. THEREFORE MAY NOT REPRESENT THE CONDITIONS AS CONSTRUCTED AT THAT TIME.

NEWMAT NORTHEAST CORP. STRETCH CEILING SYSTEMS	#	REVISIONS:	Drawn By	Checked By	81 MAHAN STREET, WEST BABYLON, NY 11704 TEL: (631) 261 1498 FAX: (631) 261 1756 Drawing Title: RIBS Job Title: AMERICAN AIRLINES Customer Name: AMERICAN AIRLINES	Scale:	Drawn By:
	A	2/26/2018	R.K.			AS NOTED	Checked By:
	B	3/1/2018	R.K.				
	C	3/7/2018	R.K.				
	D	3/15/2018	R.K.				
E	5/4/2018	R.K.				Job Number: 13-00 Date: 2/14/2018 Drawing Number: A-03.1	

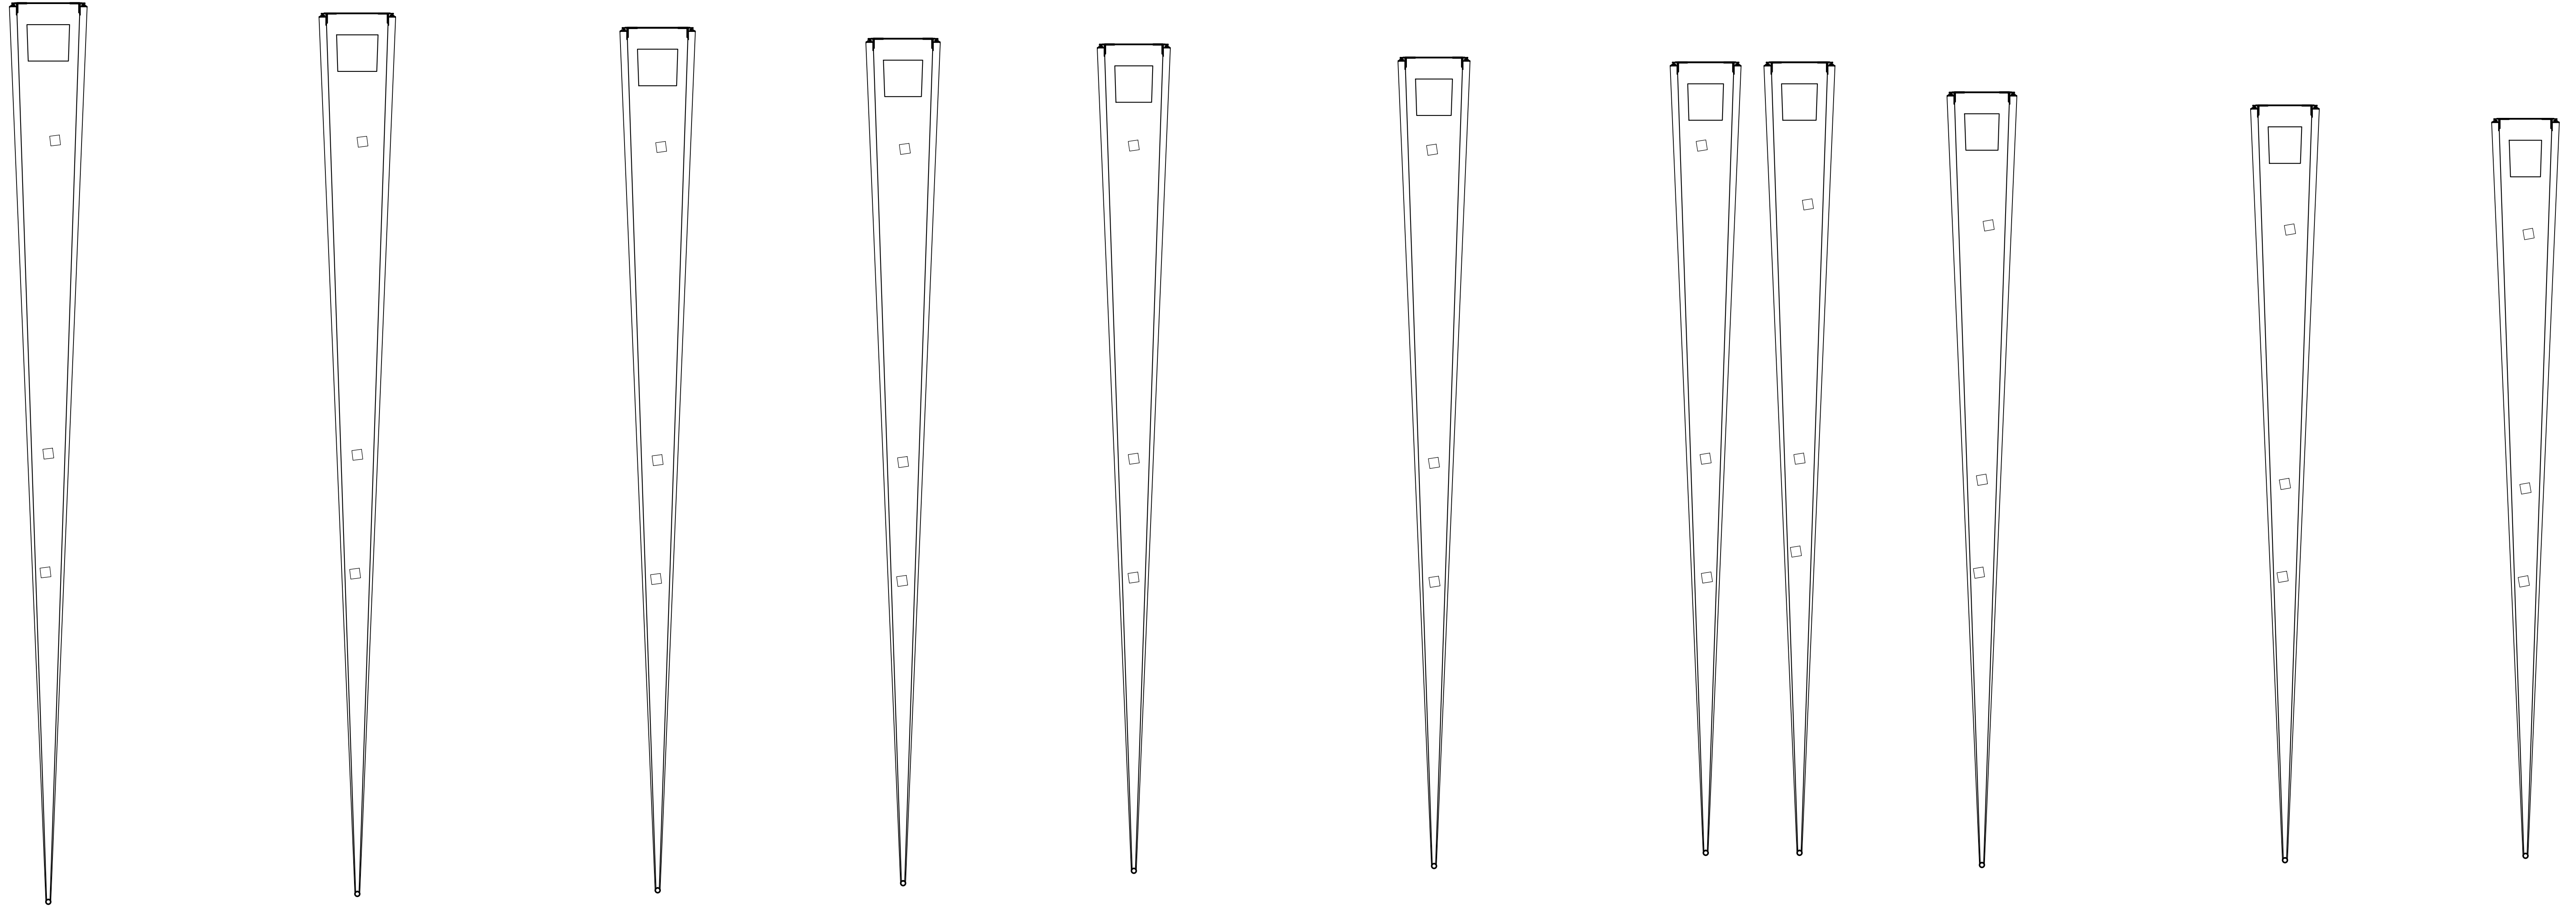

① DETAIL @ RIB #9 SCALE: 1/12"=1'-0"
 ② DETAIL @ RIB #10 SCALE: 1/12"=1'-0"
 ③ DETAIL @ RIB #11 SCALE: 1/12"=1'-0"
 ④ DETAIL @ RIB #12 SCALE: 1/12"=1'-0"
 ⑤ DETAIL @ RIB #13 SCALE: 1/12"=1'-0"
 ⑥ DETAIL @ RIB #14 SCALE: 1/12"=1'-0"
 ⑦ DETAIL @ RIB #15A&B SCALE: 1/12"=1'-0"
 ⑧ DETAIL @ RIB #16 SCALE: 1/12"=1'-0"
 ⑨ DETAIL @ RIB #17 SCALE: 1/12"=1'-0"
 ⑩ DETAIL @ RIB #18 SCALE: 1/12"=1'-0"


NOTES:

- 1) ALL DIMENSIONS AND LOCATIONS MUST BE V.I.F. PRIOR TO NEWMAT FABRICATION AND INSTALLATION.
- 2) ALL DRYWALL APPLICATIONS REQUIRE 12" CONTINUOUS 16GA (MINIMUM) METAL STRAPPING REINFORCEMENT BEHIND DRYWALL AT ALL NEWMAT ATTACHMENT LOCATIONS.
- 3) ALL "BLOCKING BY OTHERS", MUST BE CONTINUOUS, STRAIGHT, LEVEL AND/OR PLUMB AND ABLE TO WITHSTAND 30LBS. PER LINEAR FOOT OF LATERAL TENSION WHICH WILL BE EXERTED BY EACH LAYER OF MEMBRANE.


AS BUILT
10/3/2019

NOTICE:
THESE DRAWINGS WERE PRODUCED BY AND ARE THE SOLE PROPERTY OF NEWMAT USA LTD ANY AND ALL INFORMATION CONTAINED HEREIN SHALL NOT BE USED BY ANY OTHER PERSON OR COMPANY WITHOUT THE EXPRESSED WRITTEN CONSENT OF NEWMAT USA LTD. THE DRAWINGS MAY HAVE BEEN BASED ON CONSTRUCTION DRAWINGS NOT PREPARED BY NEWMAT USA LTD. THEREFORE MAY NOT REPRESENT THE CONDITIONS AS CONSTRUCTED AT THAT TIME.

NEWMAT NORTHEAST CORP. STRETCH CEILING SYSTEMS	#	REVISIONS:	Drawn By	Checked By	81 MAHAN STREET, WEST BABYLON, NY 11704 TEL: (631) 261 1498 FAX: (631) 261 1756	Scale:	Drawn By:
	A	2/26/2018	R.K.		Drawing Title: RIBS	AS NOTED	R.K.
	B	3/1/2018	R.K.		Job Title: AMERICAN AIRLINES	Job Number:	Date:
	C	3/7/2018	R.K.		Customer Name: AMERICAN AIRLINES	13-00	2/14/2018
	D	3/15/2018	R.K.			Drawing Number:	
E	5/4/2018	R.K.			A-03.2		

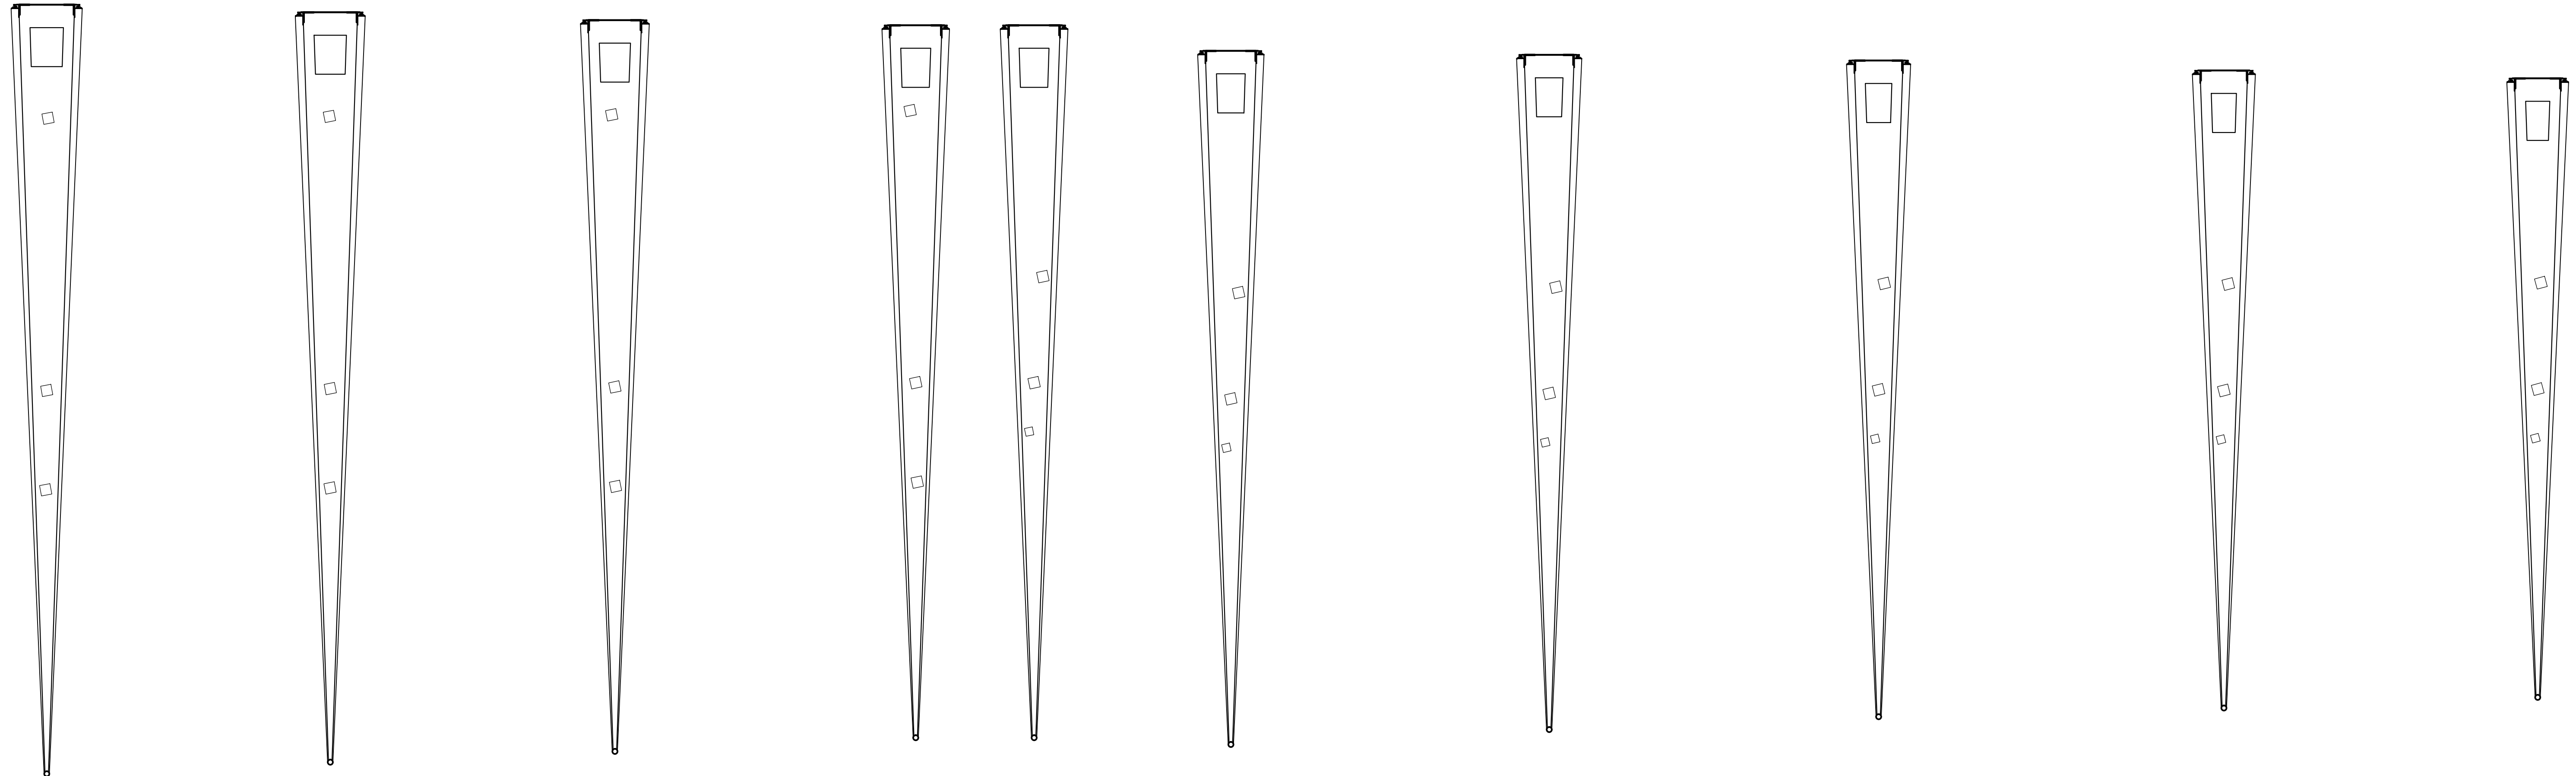

1 DETAIL @ RIB #19 SCALE: 1 1/2" = 1'-0"
 2 DETAIL @ RIB #20 SCALE: 1 1/2" = 1'-0"
 3 DETAIL @ RIB #21 SCALE: 1 1/2" = 1'-0"
 4 DETAIL @ RIB #22A&B SCALE: 1 1/2" = 1'-0"
 5 DETAIL @ RIB #23 SCALE: 1 1/2" = 1'-0"
 6 DETAIL @ RIB #24 SCALE: 1 1/2" = 1'-0"
 7 DETAIL @ RIB #25 SCALE: 1 1/2" = 1'-0"
 8 DETAIL @ RIB #26 SCALE: 1 1/2" = 1'-0"
 9 DETAIL @ RIB #27 SCALE: 1 1/2" = 1'-0"

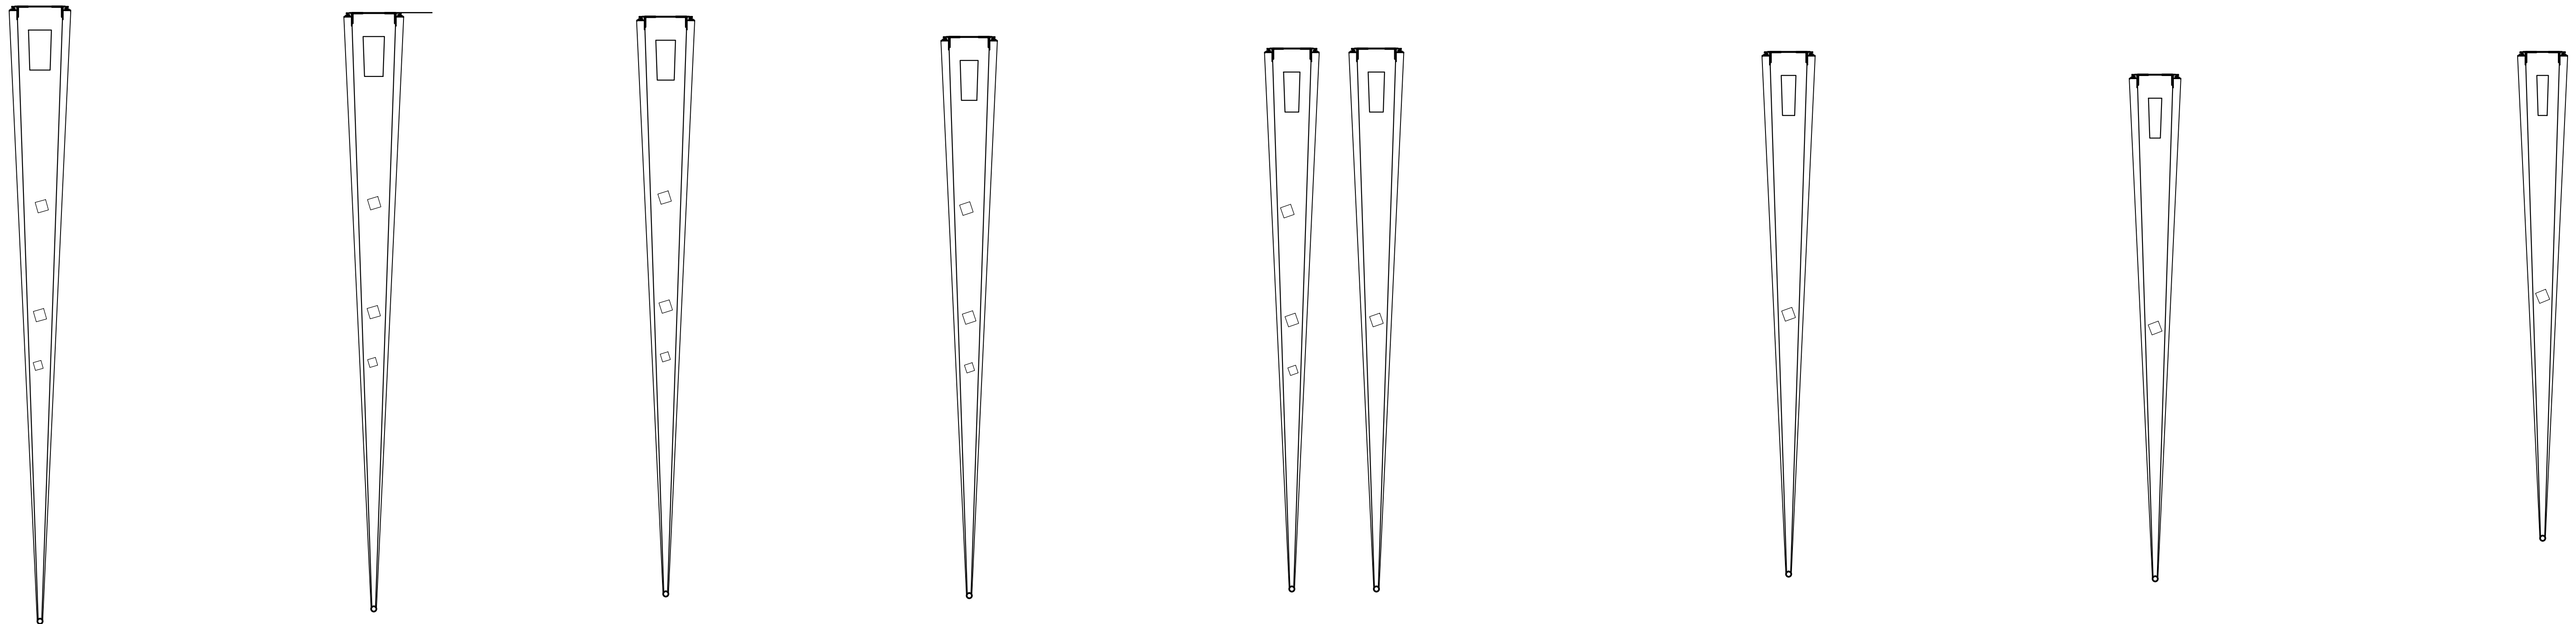











10 DETAIL @ RIB #28 SCALE: 1 1/2" = 1'-0"
 11 DETAIL @ RIB #29 SCALE: 1 1/2" = 1'-0"
 12 DETAIL @ RIB #30 SCALE: 1 1/2" = 1'-0"
 13 DETAIL @ RIB #31 SCALE: 1 1/2" = 1'-0"
 14 DETAIL @ RIB #32A&B SCALE: 1 1/2" = 1'-0"
 15 DETAIL @ RIB #33 SCALE: 1 1/2" = 1'-0"
 16 DETAIL @ RIB #34 SCALE: 1 1/2" = 1'-0"
 17 DETAIL @ RIB #35 SCALE: 1 1/2" = 1'-0"

NOTES:
 1) ALL DIMENSIONS AND LOCATIONS MUST BE V.I.F. PRIOR TO NEWMAT FABRICATION AND INSTALLATION.
 2) ALL DRYWALL APPLICATIONS REQUIRE 12" CONTINUOUS 16GA (MINIMUM) METAL STRAPPING REINFORCEMENT BEHIND DRYWALL AT ALL NEWMAT ATTACHMENT LOCATIONS.
 3) ALL "BLOCKING BY OTHERS", MUST BE CONTINUOUS, STRAIGHT, LEVEL AND/OR PLUMB AND ABLE TO WITHSTAND 30LBS. PER LINEAR FOOT OF LATERAL TENSION WHICH WILL BE EXERTED BY EACH LAYER OF MEMBRANE.

AS BUILT
10/3/2019

NOTICE:
 THESE DRAWINGS WERE PRODUCED BY AND ARE THE SOLE PROPERTY OF NEWMAT USA LTD ANY AND ALL INFORMATION CONTAINED HEREIN SHALL NOT BE USED BY ANY OTHER PERSON OR COMPANY WITHOUT THE EXPRESSED WRITTEN CONSENT OF NEWMAT USA LTD. THE DRAWINGS MAY HAVE BEEN BASED ON CONSTRUCTION DRAWINGS NOT PREPARED BY NEWMAT USA LTD. THEREFORE MAY NOT REPRESENT THE CONDITIONS AS CONSTRUCTED AT THAT TIME.

NEWMAT NORTHEAST CORP. STRETCH CEILING SYSTEMS	#	REVISIONS:	Drawn By	Checked By	81 MAHAN STREET, WEST BABYLON, NY 11704 TEL: (631) 261 1498 FAX: (631) 261 1756 Drawing Title: RIBS Job Title: AMERICAN AIRLINES Customer Name: AMERICAN AIRLINES	Scale:	Drawn By:
	A	2/26/2018	R.K.			AS NOTED	Checked By:
	B	3/1/2018	R.K.				Job Number:
	C	3/7/2018	R.K.				Date:
	D	3/15/2018	R.K.				Drawing Number:
E	5/4/2018	R.K.			A-03.3		

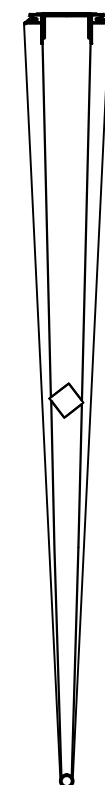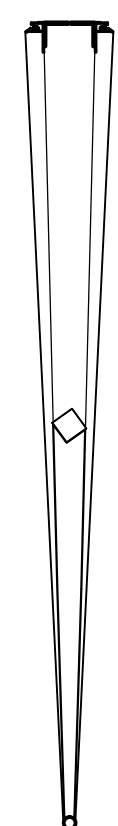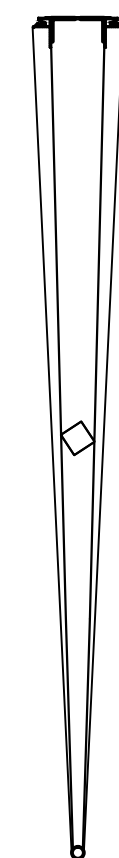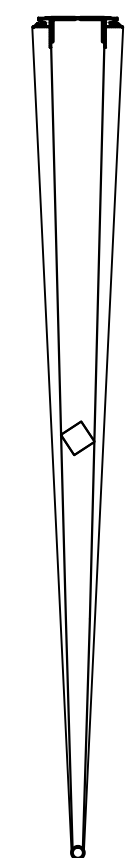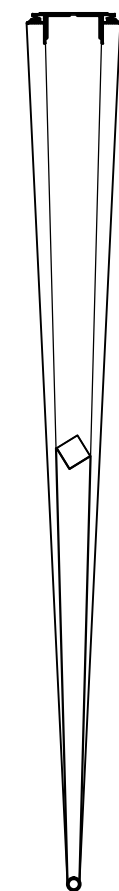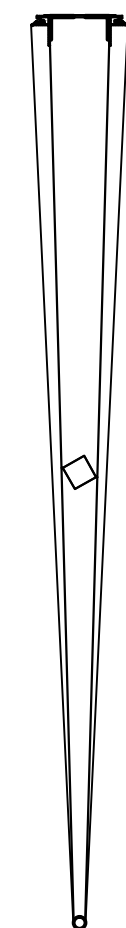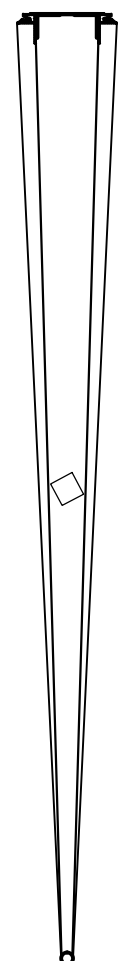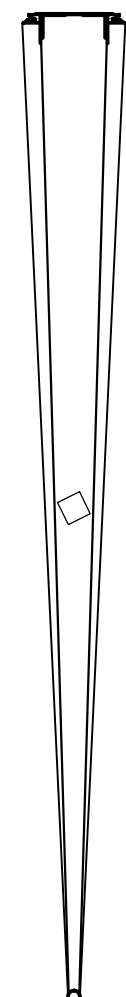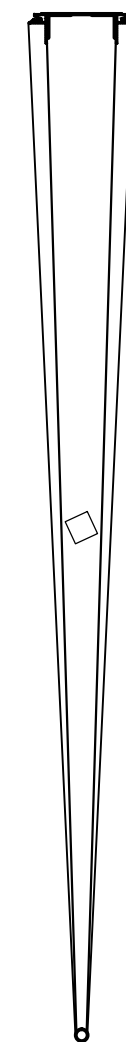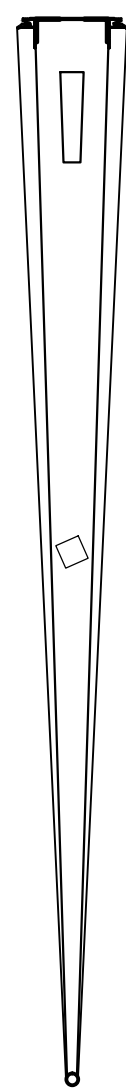

1 DETAIL @ RIB #36
SCALE: 1 1/2" = 1'-0"

2 DETAIL @ RIB #37
SCALE: 1 1/2" = 1'-0"

3 DETAIL @ RIB #38
SCALE: 1 1/2" = 1'-0"

4 DETAIL @ RIB #39
SCALE: 1 1/2" = 1'-0"









5 DETAIL @ RIB #40
SCALE: 1 1/2" = 1'-0"

6 DETAIL @ RIB #41
SCALE: 1 1/2" = 1'-0"

7 DETAIL @ RIB #42A&B
SCALE: 1 1/2" = 1'-0"

8 DETAIL @ RIB #43
SCALE: 1 1/2" = 1'-0"

9 DETAIL @ RIB #44
SCALE: 1 1/2" = 1'-0"

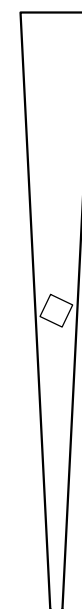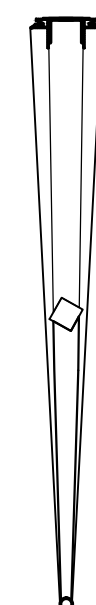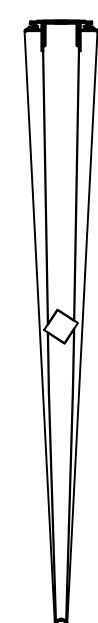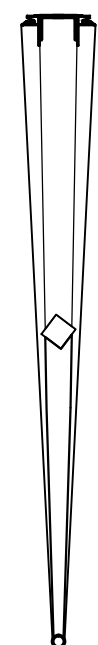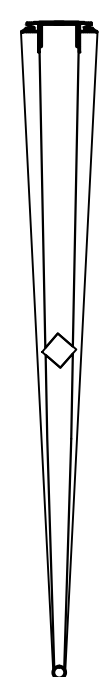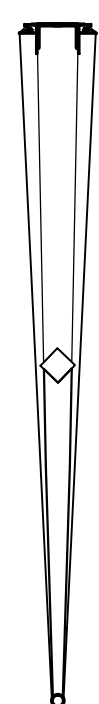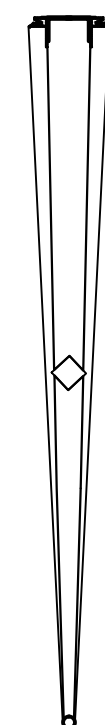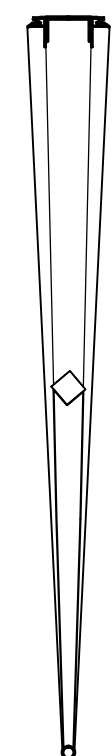

10 DETAIL @ RIB #45
SCALE: 1 1/2" = 1'-0"

11 DETAIL @ RIB #46
SCALE: 1 1/2" = 1'-0"

12 DETAIL @ RIB #47
SCALE: 1 1/2" = 1'-0"

13 DETAIL @ RIB #48
SCALE: 1 1/2" = 1'-0"

14 DETAIL @ RIB #49
SCALE: 1 1/2" = 1'-0"

15 DETAIL @ RIB #50
SCALE: 1 1/2" = 1'-0"

16 DETAIL @ RIB #51
SCALE: 1 1/2" = 1'-0"

17 DETAIL @ END CAP/ RIB #52
SCALE: 1 1/2" = 1'-0"


NOTES:

- 1) ALL DIMENSIONS AND LOCATIONS MUST BE V.I.F. PRIOR TO NEWMAT FABRICATION AND INSTALLATION.
- 2) ALL DRYWALL APPLICATIONS REQUIRE 12" CONTINUOUS 16GA (MINIMUM) METAL STRAPPING REINFORCEMENT BEHIND DRYWALL AT ALL NEWMAT ATTACHMENT LOCATIONS.
- 3) ALL "BLOCKING BY OTHERS", MUST BE CONTINUOUS, STRAIGHT, LEVEL AND/OR PLUMB AND ABLE TO WITHSTAND 30LBS. PER LINEAR FOOT OF LATERAL TENSION WHICH WILL BE EXERTED BY EACH LAYER OF MEMBRANE.

AS BUILT
10/3/2019


NOTICE:
THESE DRAWINGS WERE PRODUCED BY AND ARE THE SOLE PROPERTY OF NEWMAT USA LTD ANY AND ALL INFORMATION CONTAINED HEREIN SHALL NOT BE USED BY ANY OTHER PERSON OR COMPANY WITHOUT THE EXPRESSED WRITTEN CONSENT OF NEWMAT USA LTD. THE DRAWINGS MAY HAVE BEEN BASED ON CONSTRUCTION DRAWINGS NOT PREPARED BY NEWMAT USA LTD. THEREFORE MAY NOT REPRESENT THE CONDITIONS AS CONSTRUCTED AT THAT TIME.

NEWMAT NORTHEAST CORP. newmat® STRETCH CEILING SYSTEMS	#	REVISIONS:	Drawn By:	Checked By:	81 MAHAN STREET, WEST BABYLON, NY 11704 TEL: (631) 261 1498 FAX: (631) 261 1756	Scale:	Drawn By:
	A	2/26/2018	R.K.		Drawing Title: RIBS	AS NOTED	R.K.
	B	3/1/2018	R.K.		Job Title: AMERICAN AIRLINES	Job Number: 13-00	Date: 2/14/2018
	C	3/7/2018	R.K.		Customer Name: AMERICAN AIRLINES	Drawing Number: A-03.4	
	D	3/15/2018	R.K.				
E	5/4/2018	R.K.					

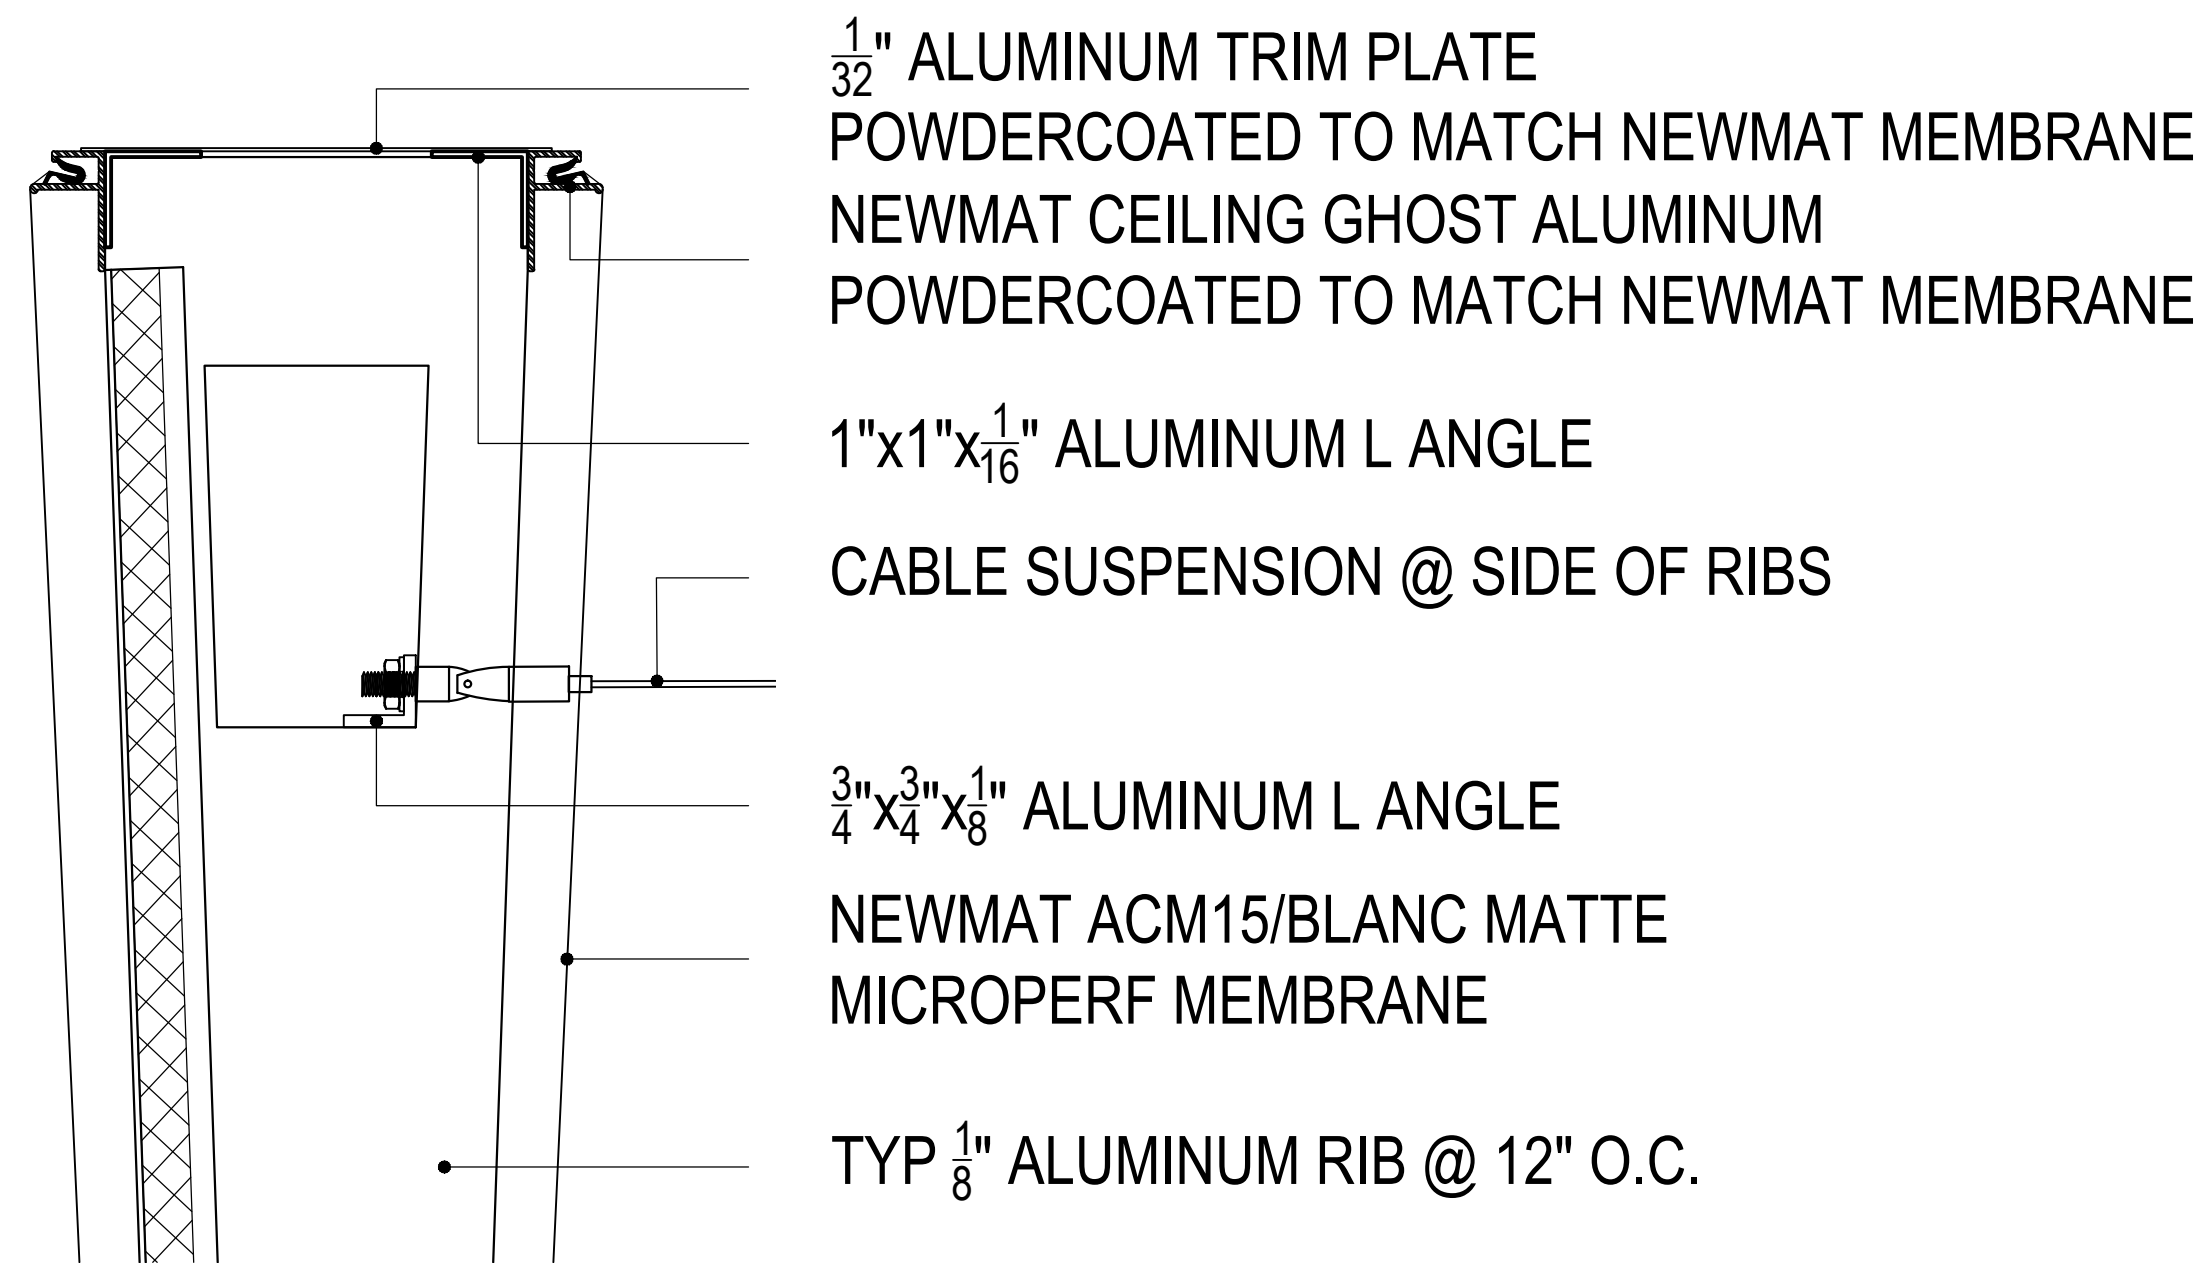


1/32" ALUMINUM TRIM PLATE
POWDERCOATED TO MATCH NEWMAT MEMBRANE
NEWMAT CEILING GHOST ALUMINUM
POWDERCOATED TO MATCH NEWMAT MEMBRANE
1"x1"x1/16" ALUMINUM L ANGLE
CABLE SUSPENSION @ SIDE OF RIBS
3/4"x3/4"x1/8" ALUMINUM L ANGLE
NEWMAT ACM15/BLANC MATTE
MICROPERF MEMBRANE
TYP 1/8" ALUMINUM RIB @ 12" O.C.

1 TYP DETAIL @ TOP OF RIB
SCALE: 6"=1'-0"

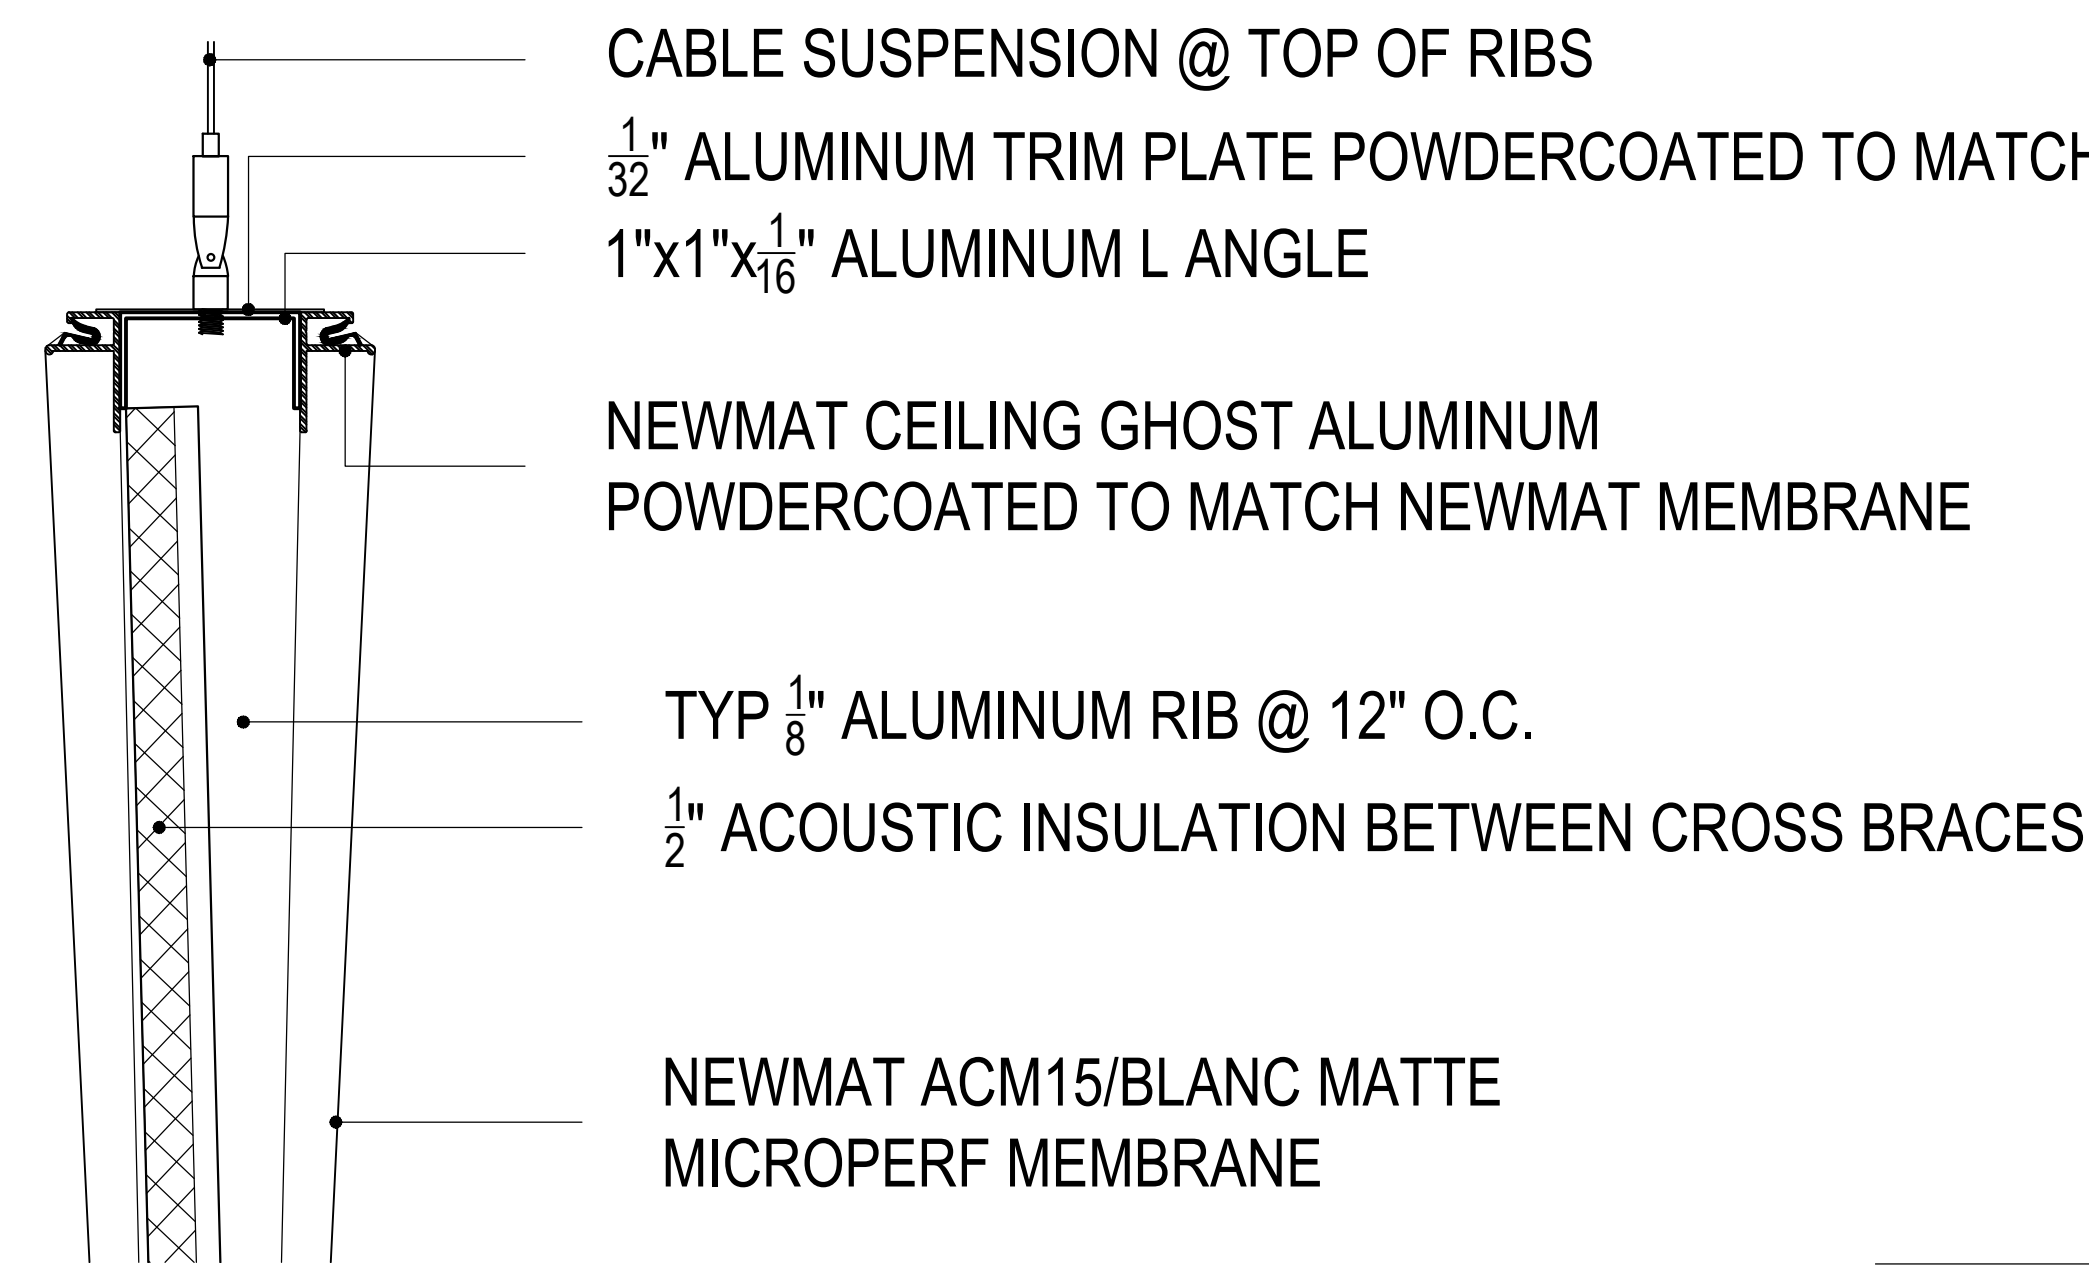


CABLE SUSPENSION @ TOP OF RIBS
1/32" ALUMINUM TRIM PLATE POWDERCOATED TO MATCH NEWMAT MEMBRANE
1"x1"x1/16" ALUMINUM L ANGLE
NEWMAT CEILING GHOST ALUMINUM
POWDERCOATED TO MATCH NEWMAT MEMBRANE
TYP 1/8" ALUMINUM RIB @ 12" O.C.
1/2" ACOUSTIC INSULATION BETWEEN CROSS BRACES
NEWMAT ACM15/BLANC MATTE
MICROPERF MEMBRANE

4 TYP DETAIL @ TOP OF RIB
SCALE: 6"=1'-0"

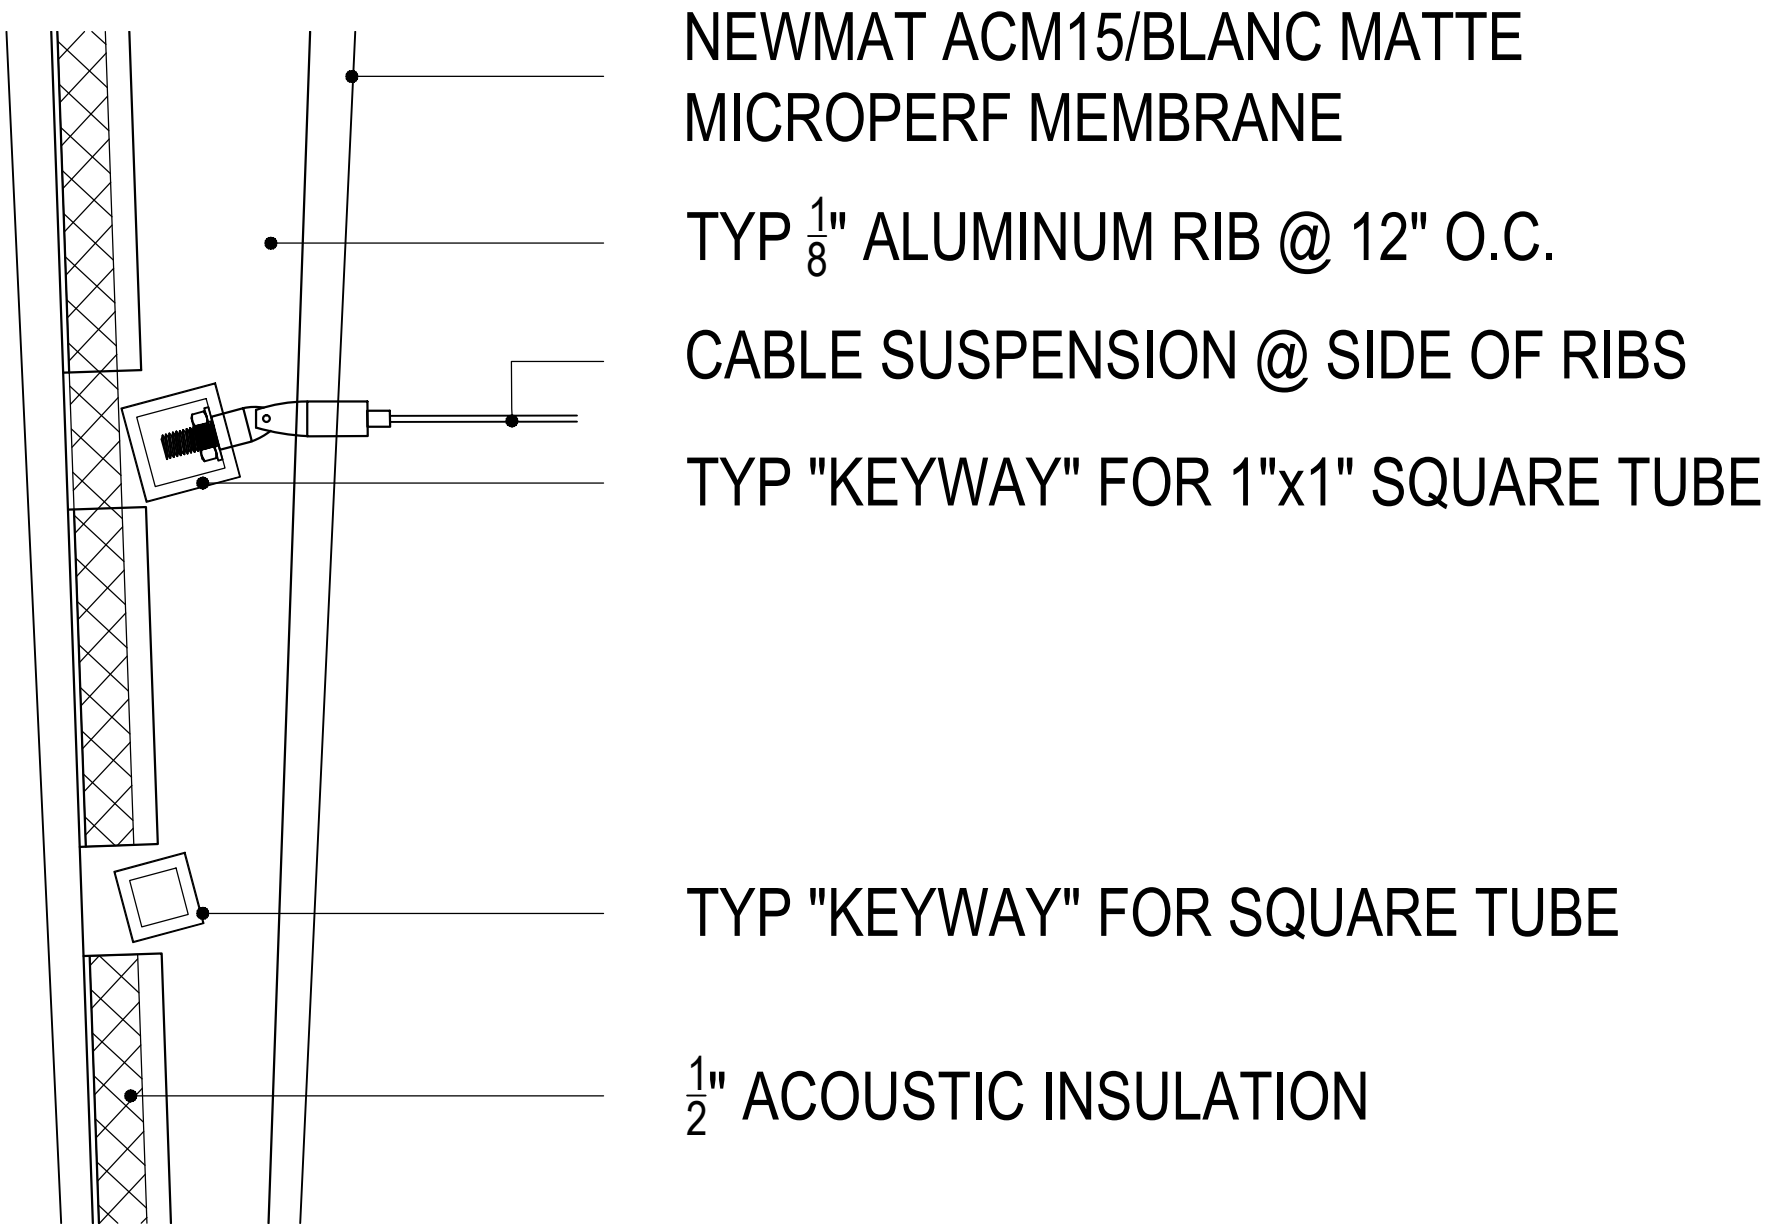


NEWMAT ACM15/BLANC MATTE
MICROPERF MEMBRANE
TYP 1/8" ALUMINUM RIB @ 12" O.C.
CABLE SUSPENSION @ SIDE OF RIBS
TYP "KEYWAY" FOR 1"x1" SQUARE TUBE
TYP "KEYWAY" FOR SQUARE TUBE
1/2" ACOUSTIC INSULATION

2 TYP DETAIL @ CENTER OF RIBS
SCALE: 6"=1'-0"

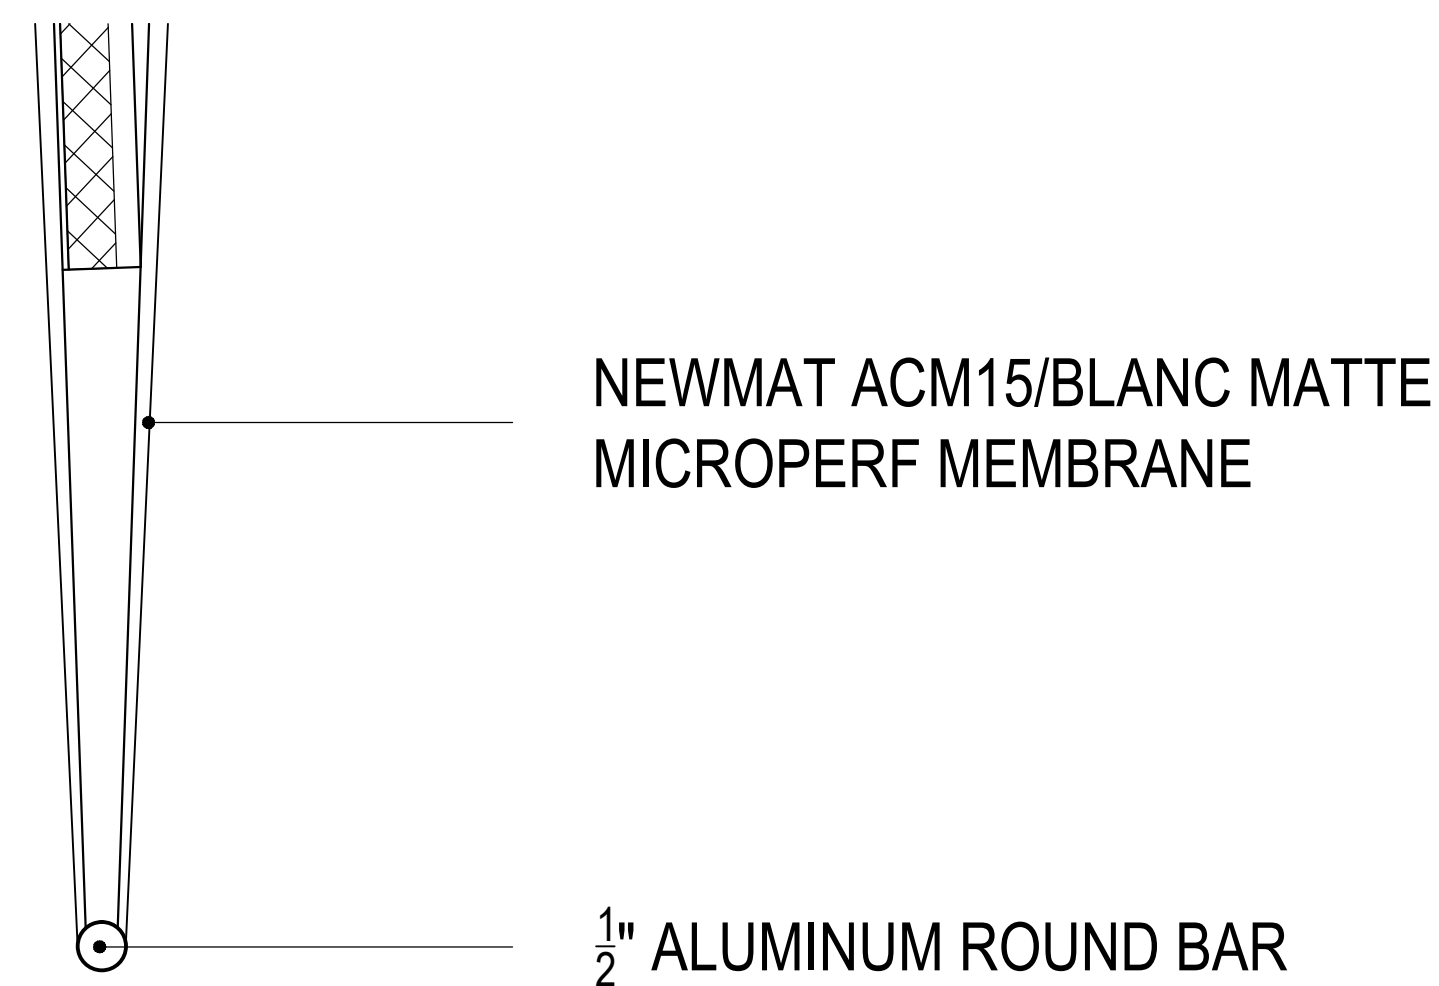


NEWMAT ACM15/BLANC MATTE
MICROPERF MEMBRANE
1/2" ALUMINUM ROUND BAR

3 TYP DETAIL @ BOTTOM OF RIB
SCALE: 6"=1'-0"

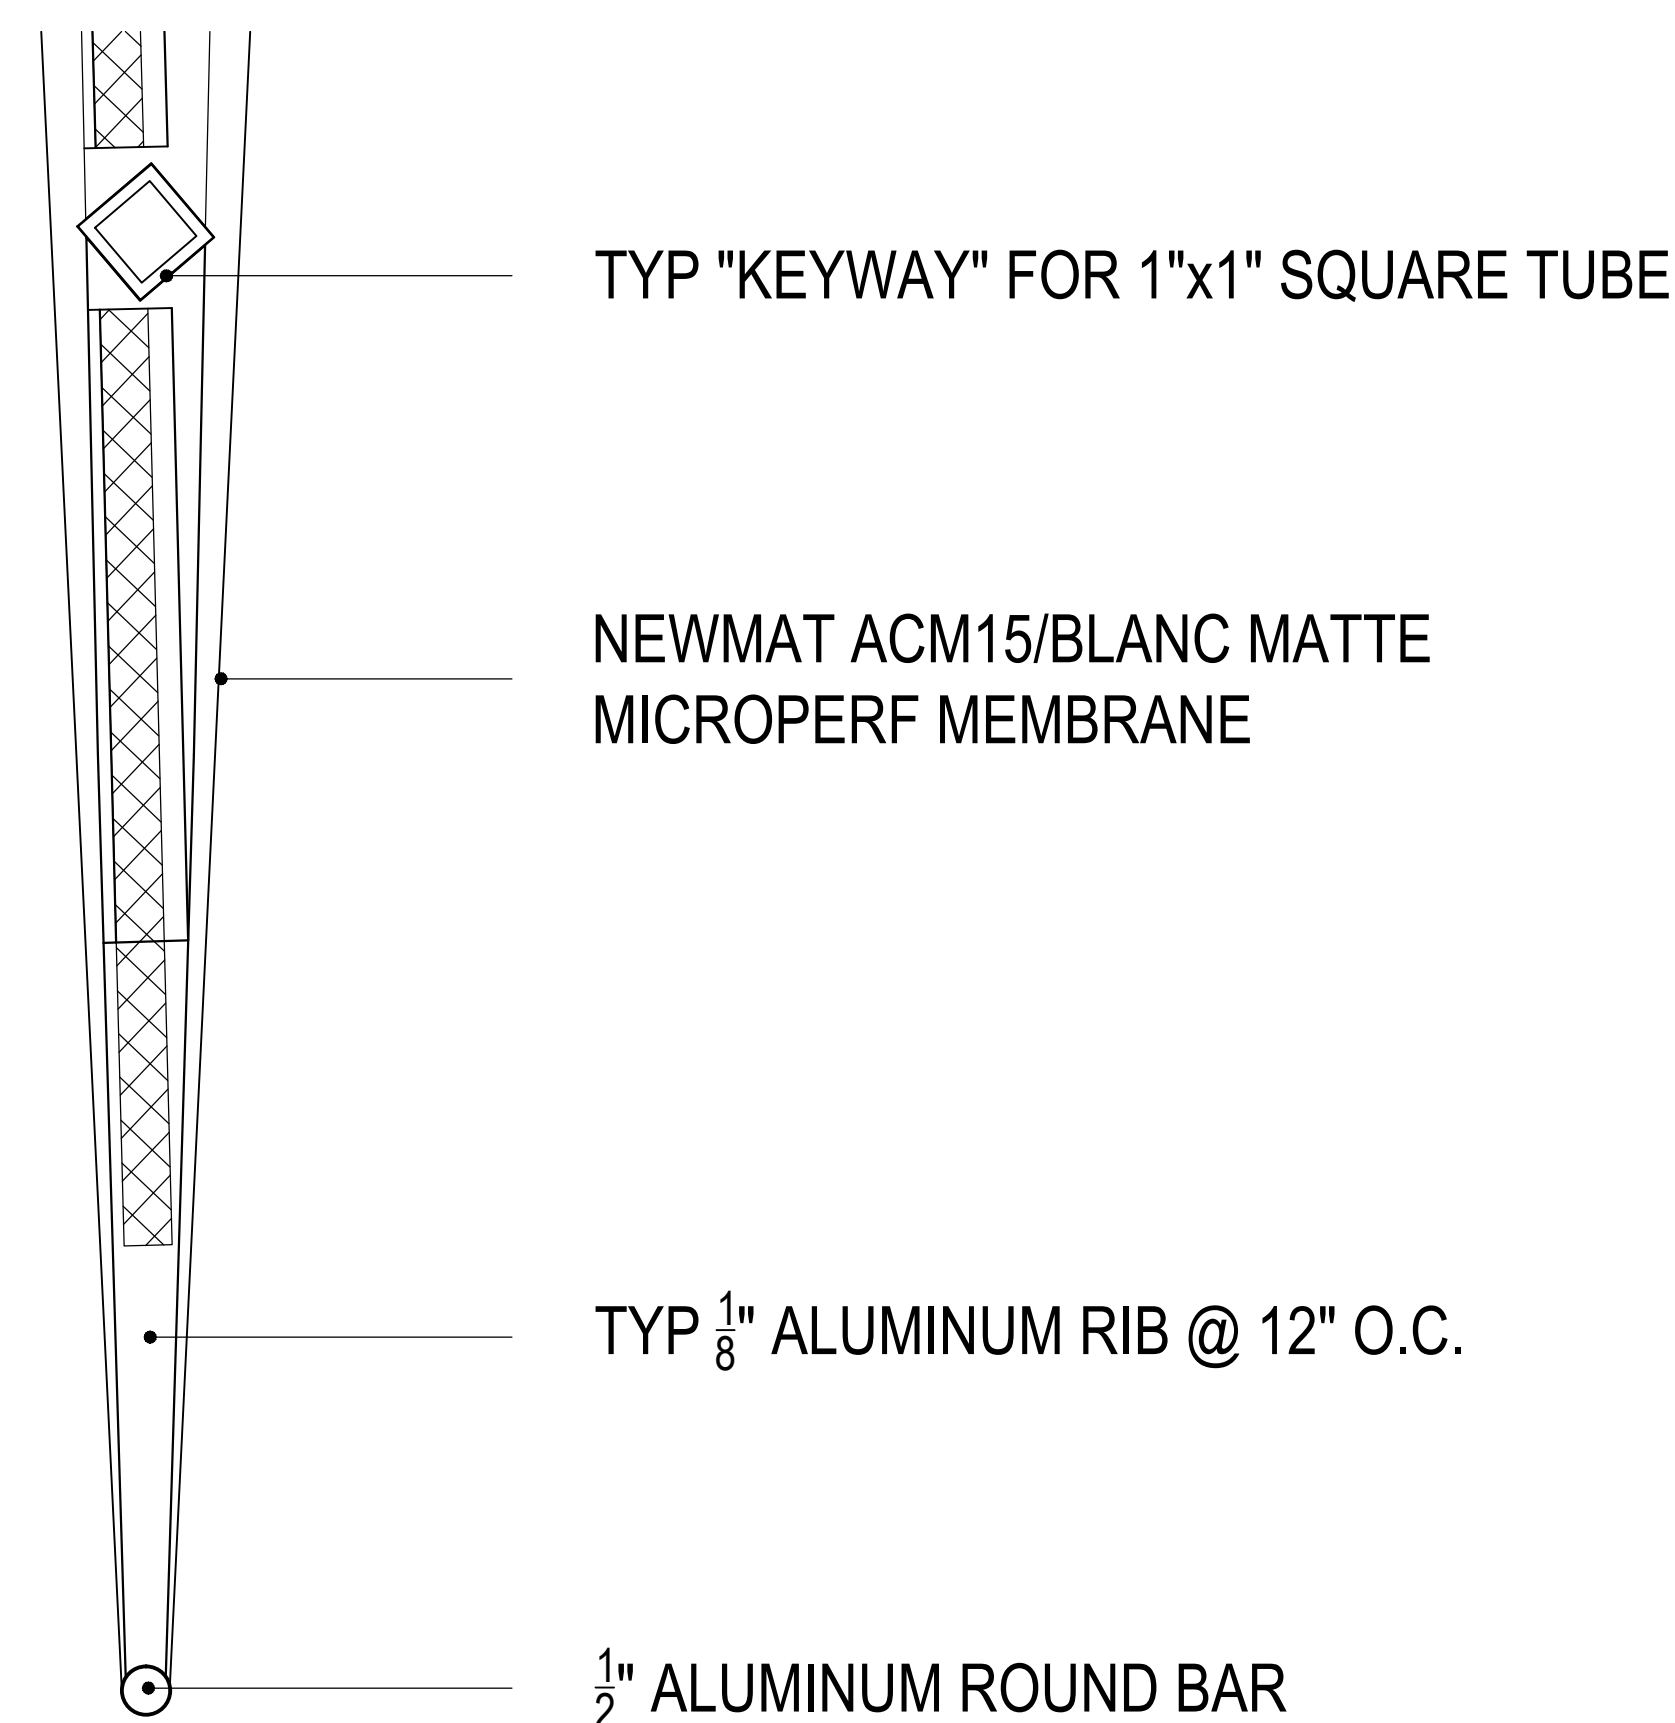

TYP "KEYWAY" FOR 1"x1" SQUARE TUBE
NEWMAT ACM15/BLANC MATTE
MICROPERF MEMBRANE
TYP 1/8" ALUMINUM RIB @ 12" O.C.
1/2" ALUMINUM ROUND BAR

5 TYP DETAIL @ CENTER OF RIBS
SCALE: 6"=1'-0"

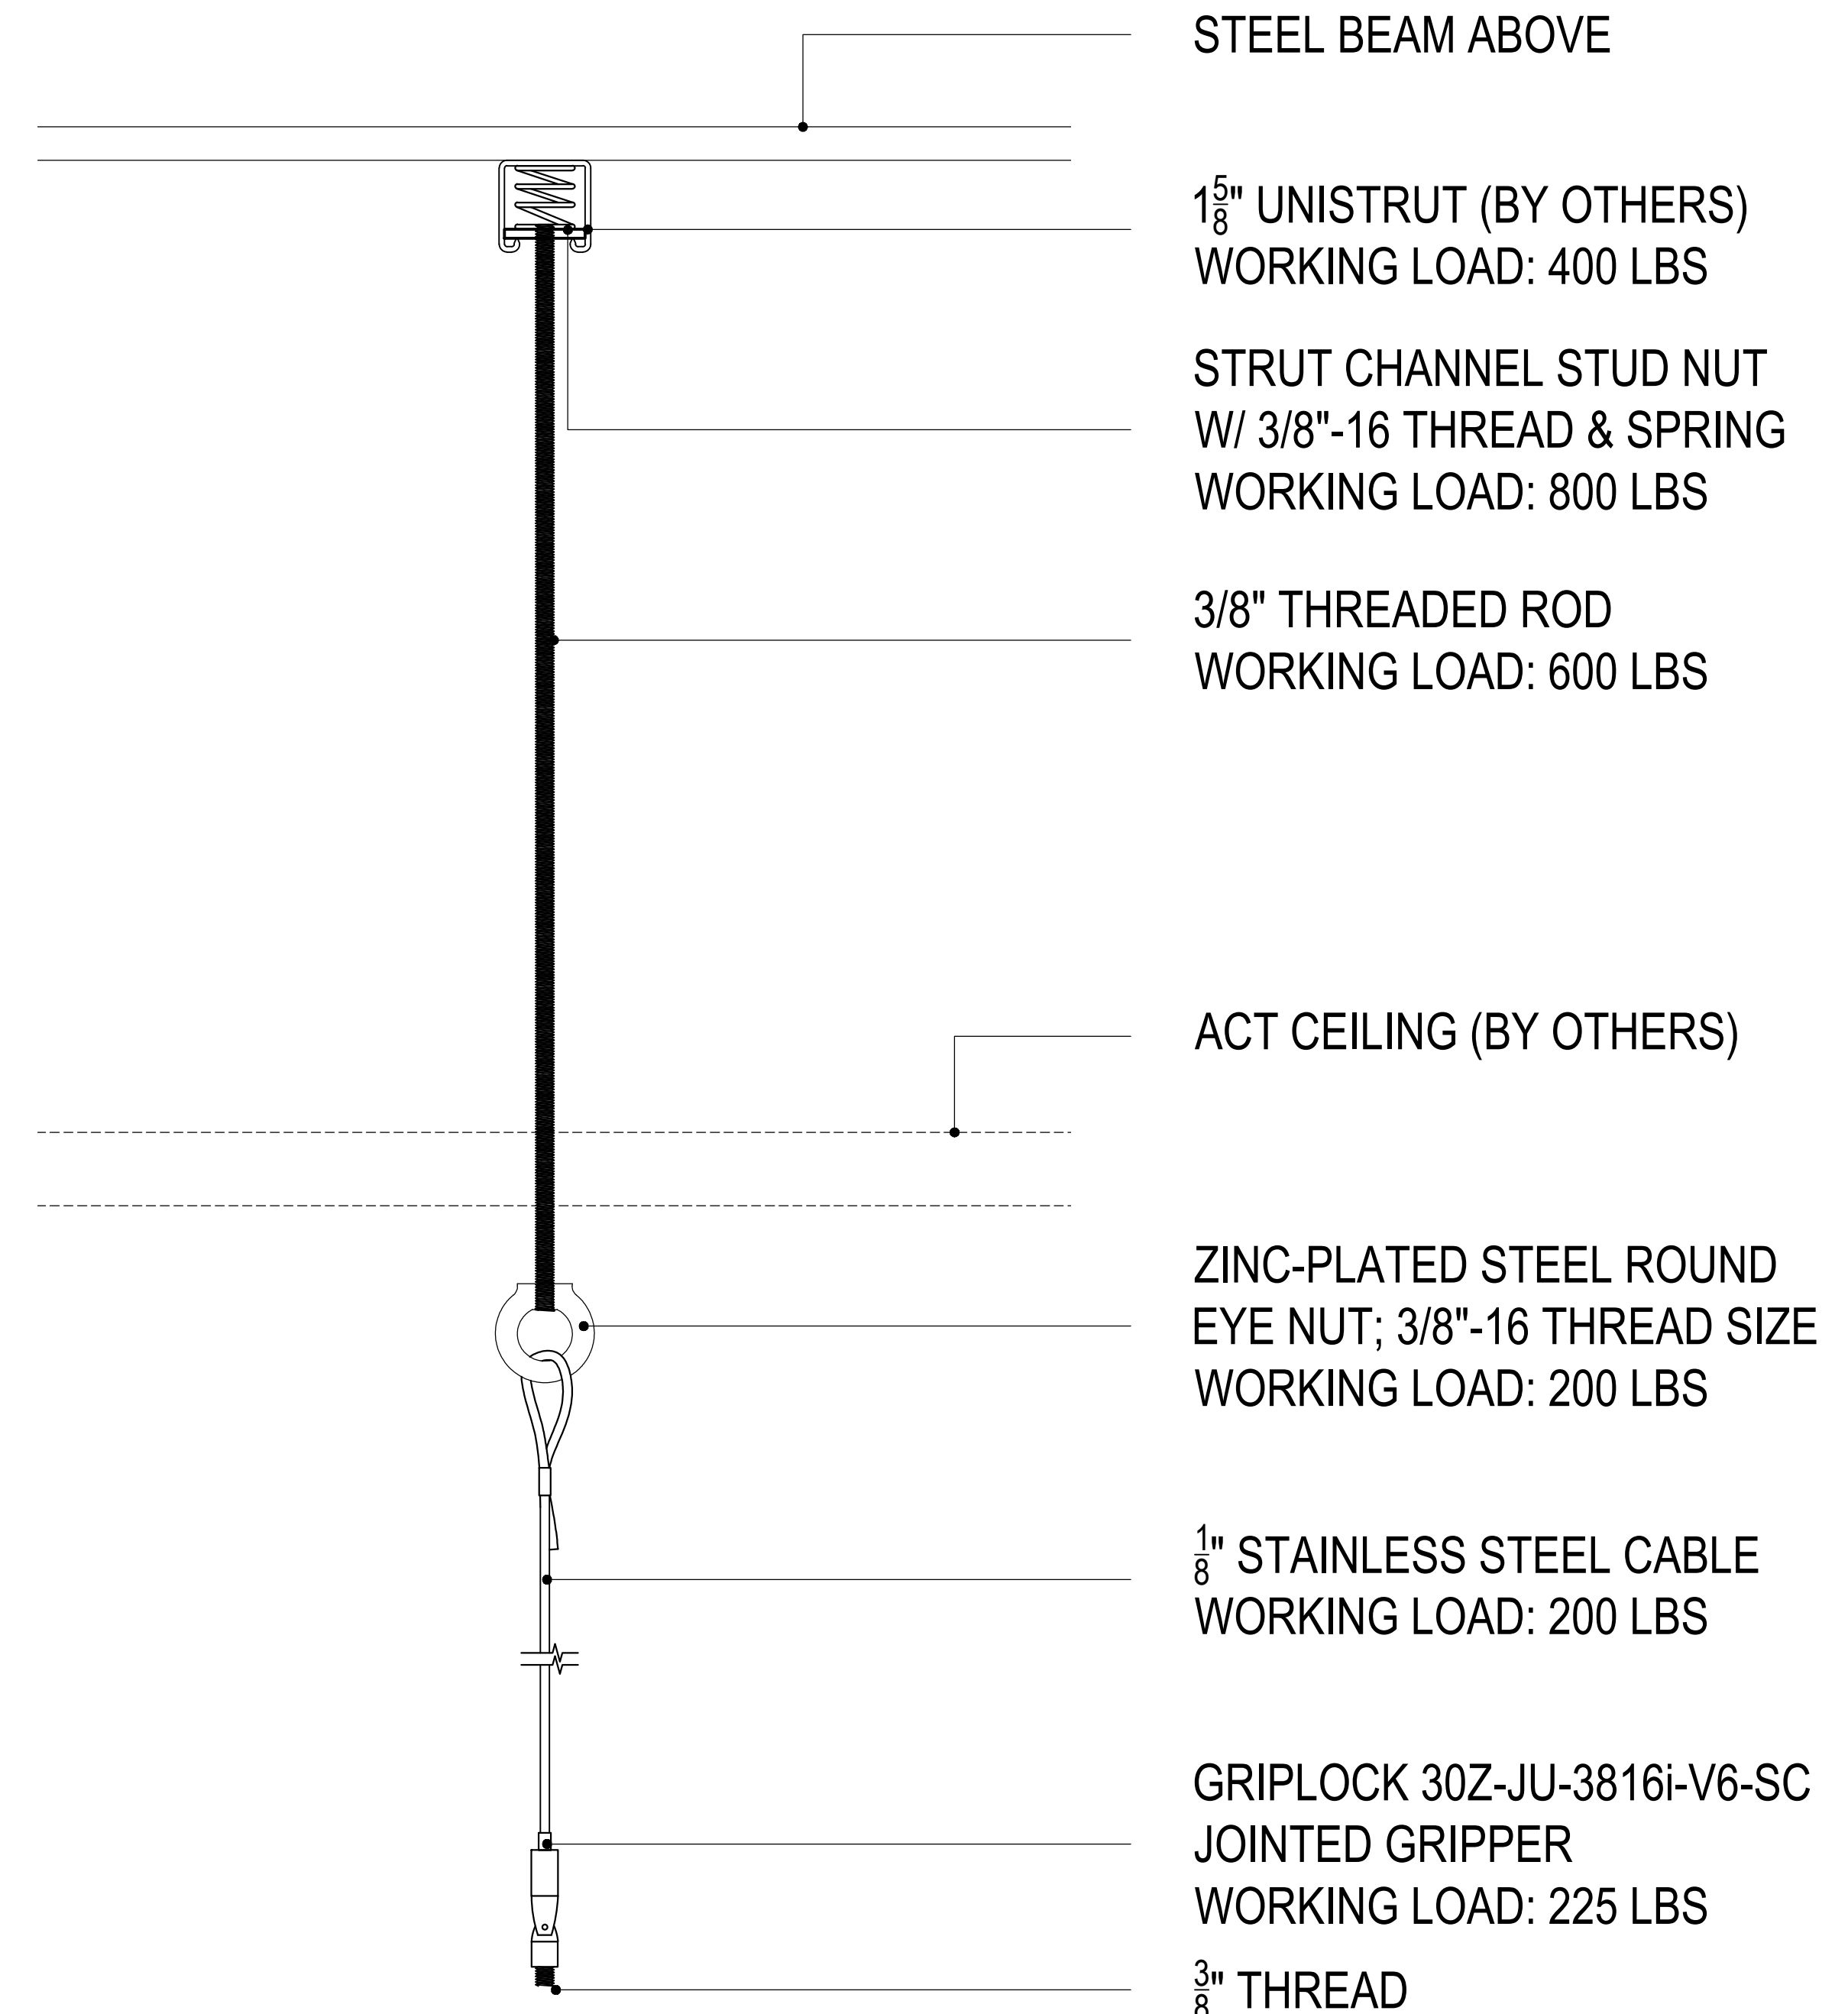

STEEL BEAM ABOVE
1 5/8" UNISTRUT (BY OTHERS)
WORKING LOAD: 400 LBS
STRUT CHANNEL STUD NUT
W/ 3/8"-16 THREAD & SPRING
WORKING LOAD: 800 LBS
3/8" THREADED ROD
WORKING LOAD: 600 LBS
ACT CEILING (BY OTHERS)
ZINC-PLATED STEEL ROUND
EYE NUT; 3/8"-16 THREAD SIZE
WORKING LOAD: 200 LBS
1/8" STAINLESS STEEL CABLE
WORKING LOAD: 200 LBS
GRIPLOCK 30Z-JU-3816i-V6-SC
JOINTED GRIPPER
WORKING LOAD: 225 LBS
3/8" THREAD


6 DETAIL @ UNISTRUT & SUSPENSION COMPONENTS
SCALE: 6"=1'-0"

NOTES:
1) ALL DIMENSIONS AND LOCATIONS MUST BE V.I.F. PRIOR TO NEWMAT FABRICATION AND INSTALLATION.
2) ALL DRYWALL APPLICATIONS REQUIRE 12" CONTINUOUS 16GA (MINIMUM) METAL STRAPPING REINFORCEMENT BEHIND DRYWALL AT ALL NEWMAT ATTACHMENT LOCATIONS.
3) ALL "BLOCKING BY OTHERS" MUST BE CONTINUOUS, STRAIGHT, LEVEL AND/OR PLUMB AND ABLE TO WITHSTAND 30LBS. PER LINEAR FOOT OF LATERAL TENSION WHICH WILL BE EXERTED BY EACH LAYER OF MEMBRANE.

AS BUILT
10/3/2019

NOTICE:
THESE DRAWINGS WERE PRODUCED BY AND ARE THE SOLE PROPERTY OF NEWMAT USA LTD ANY AND ALL INFORMATION CONTAINED HEREIN SHALL NOT BE USED BY ANY OTHER PERSON OR COMPANY WITHOUT THE EXPRESSED WRITTEN CONSENT OF NEWMAT USA LTD. THE DRAWINGS MAY HAVE BEEN BASED ON CONSTRUCTION DRAWINGS NOT PREPARED BY NEWMAT USA LTD. THEREFORE MAY NOT REPRESENT THE CONDITIONS AS CONSTRUCTED AT THAT TIME.

NEWMAT NORTHEAST CORP. STRETCH CEILING SYSTEMS	#	REVISIONS:	Drawn	Checked	81 MAHAN STREET, WEST BABYLON, NY 11704 TEL: (631) 261 1498 FAX: (631) 261 1756 Drawing Title: DETAIL Job Title: AMERICAN AIRLINES Customer Name: AMERICAN AIRLINES	Scale:	Drawn By:
	A	2/26/2018	R.K.			AS NOTED	Checked By:
	B	3/1/2018	R.K.			Job Number:	Date:
	C	3/7/2018	R.K.			13-00	2/14/2018
	D	3/15/2018	R.K.			Drawing Number:	
E	6/18/2018	R.K.		A-04			

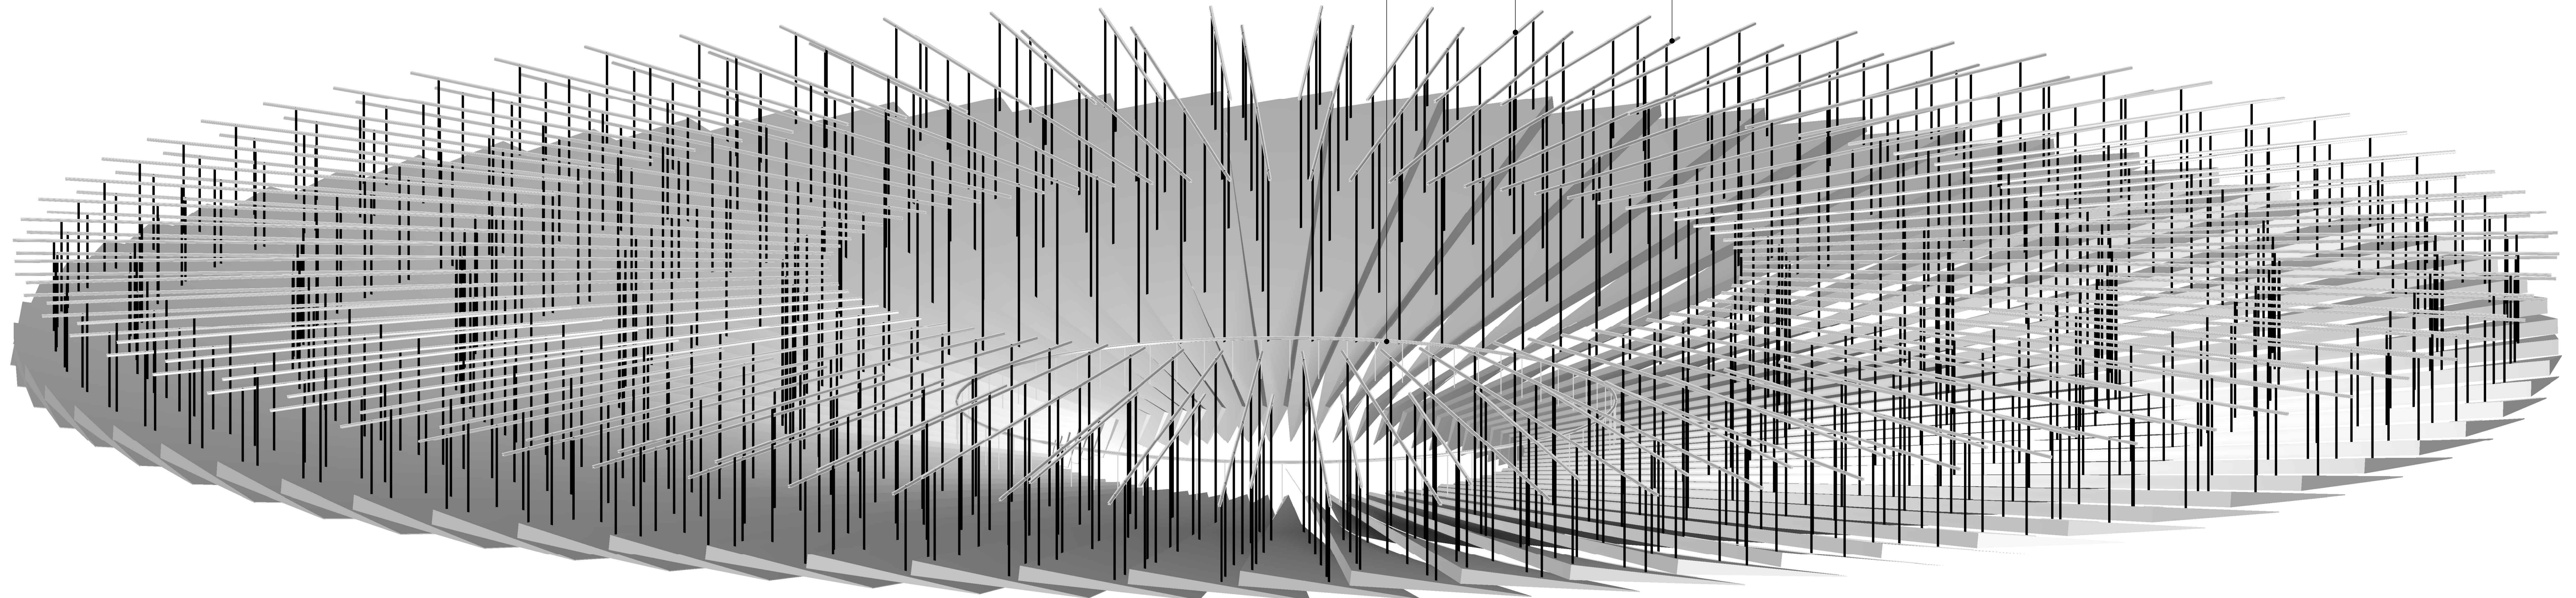

UNISTRUT RING BELOW CATWALK
4'-4" FROM END OF BLADE(BY MAREK BROTHERS)

PRIMARY UNISTRUT ABOVE EACH BLADE
12" IN FROM WIDE EDGE (BY MAREK BROTHERS)

SECONDARY UNISTRUT ABOVE EACH BLADE
ALIGNED W/ CENTERLINE (BY MAREK BROTHERS)

1 VIEW OF SUSPENSION LAYOUT

SCALE: NTS


NOTES:

- 1) ALL DIMENSIONS AND LOCATIONS MUST BE V.I.F. PRIOR TO NEWMAT FABRICATION AND INSTALLATION.
- 2) ALL DRYWALL APPLICATIONS REQUIRE 12" CONTINUOUS 16GA (MINIMUM) METAL STRAPPING REINFORCEMENT BEHIND DRYWALL AT ALL NEWMAT ATTACHMENT LOCATIONS.
- 3) ALL "BLOCKING BY OTHERS", MUST BE CONTINUOUS, STRAIGHT, LEVEL AND/OR PLUMB AND ABLE TO WITHSTAND 30LBS. PER LINEAR FOOT OF LATERAL TENSION WHICH WILL BE EXERTED BY EACH LAYER OF MEMBRANE.

AS BUILT
10/3/2019

NOTICE:
THESE DRAWINGS WERE PRODUCED BY AND ARE THE SOLE PROPERTY OF NEWMAT USA LTD AND ALL INFORMATION CONTAINED HEREIN SHALL NOT BE USED BY ANY OTHER PERSON OR COMPANY WITHOUT THE EXPRESSED WRITTEN CONSENT OF NEWMAT USA LTD. THE DRAWINGS MAY HAVE BEEN BASED ON CONSTRUCTION DRAWINGS NOT PREPARED BY NEWMAT USA LTD. THEREFORE MAY NOT REPRESENT THE CONDITIONS AS CONSTRUCTED AT THAT TIME.

NEWMAT NORTHEAST CORP. newmat® STRETCH CEILING SYSTEMS	#	REVISIONS:	Drawn	Checked	81 MAHAN STREET, WEST BABYLON, NY 11704 TEL. (631) 261 1498 FAX (631) 261 1756	Scale:	Drawn By:
	A	2/26/2018	R.K.			AS NOTED	R.K.
	B				Job Title:		Checked By:
	C				AMERICAN AIRLINES	Job Number:	
	D				AMERICAN AIRLINES	13-00	Date:
E						2/14/2018	
						Drawing Number:	
						A-05	

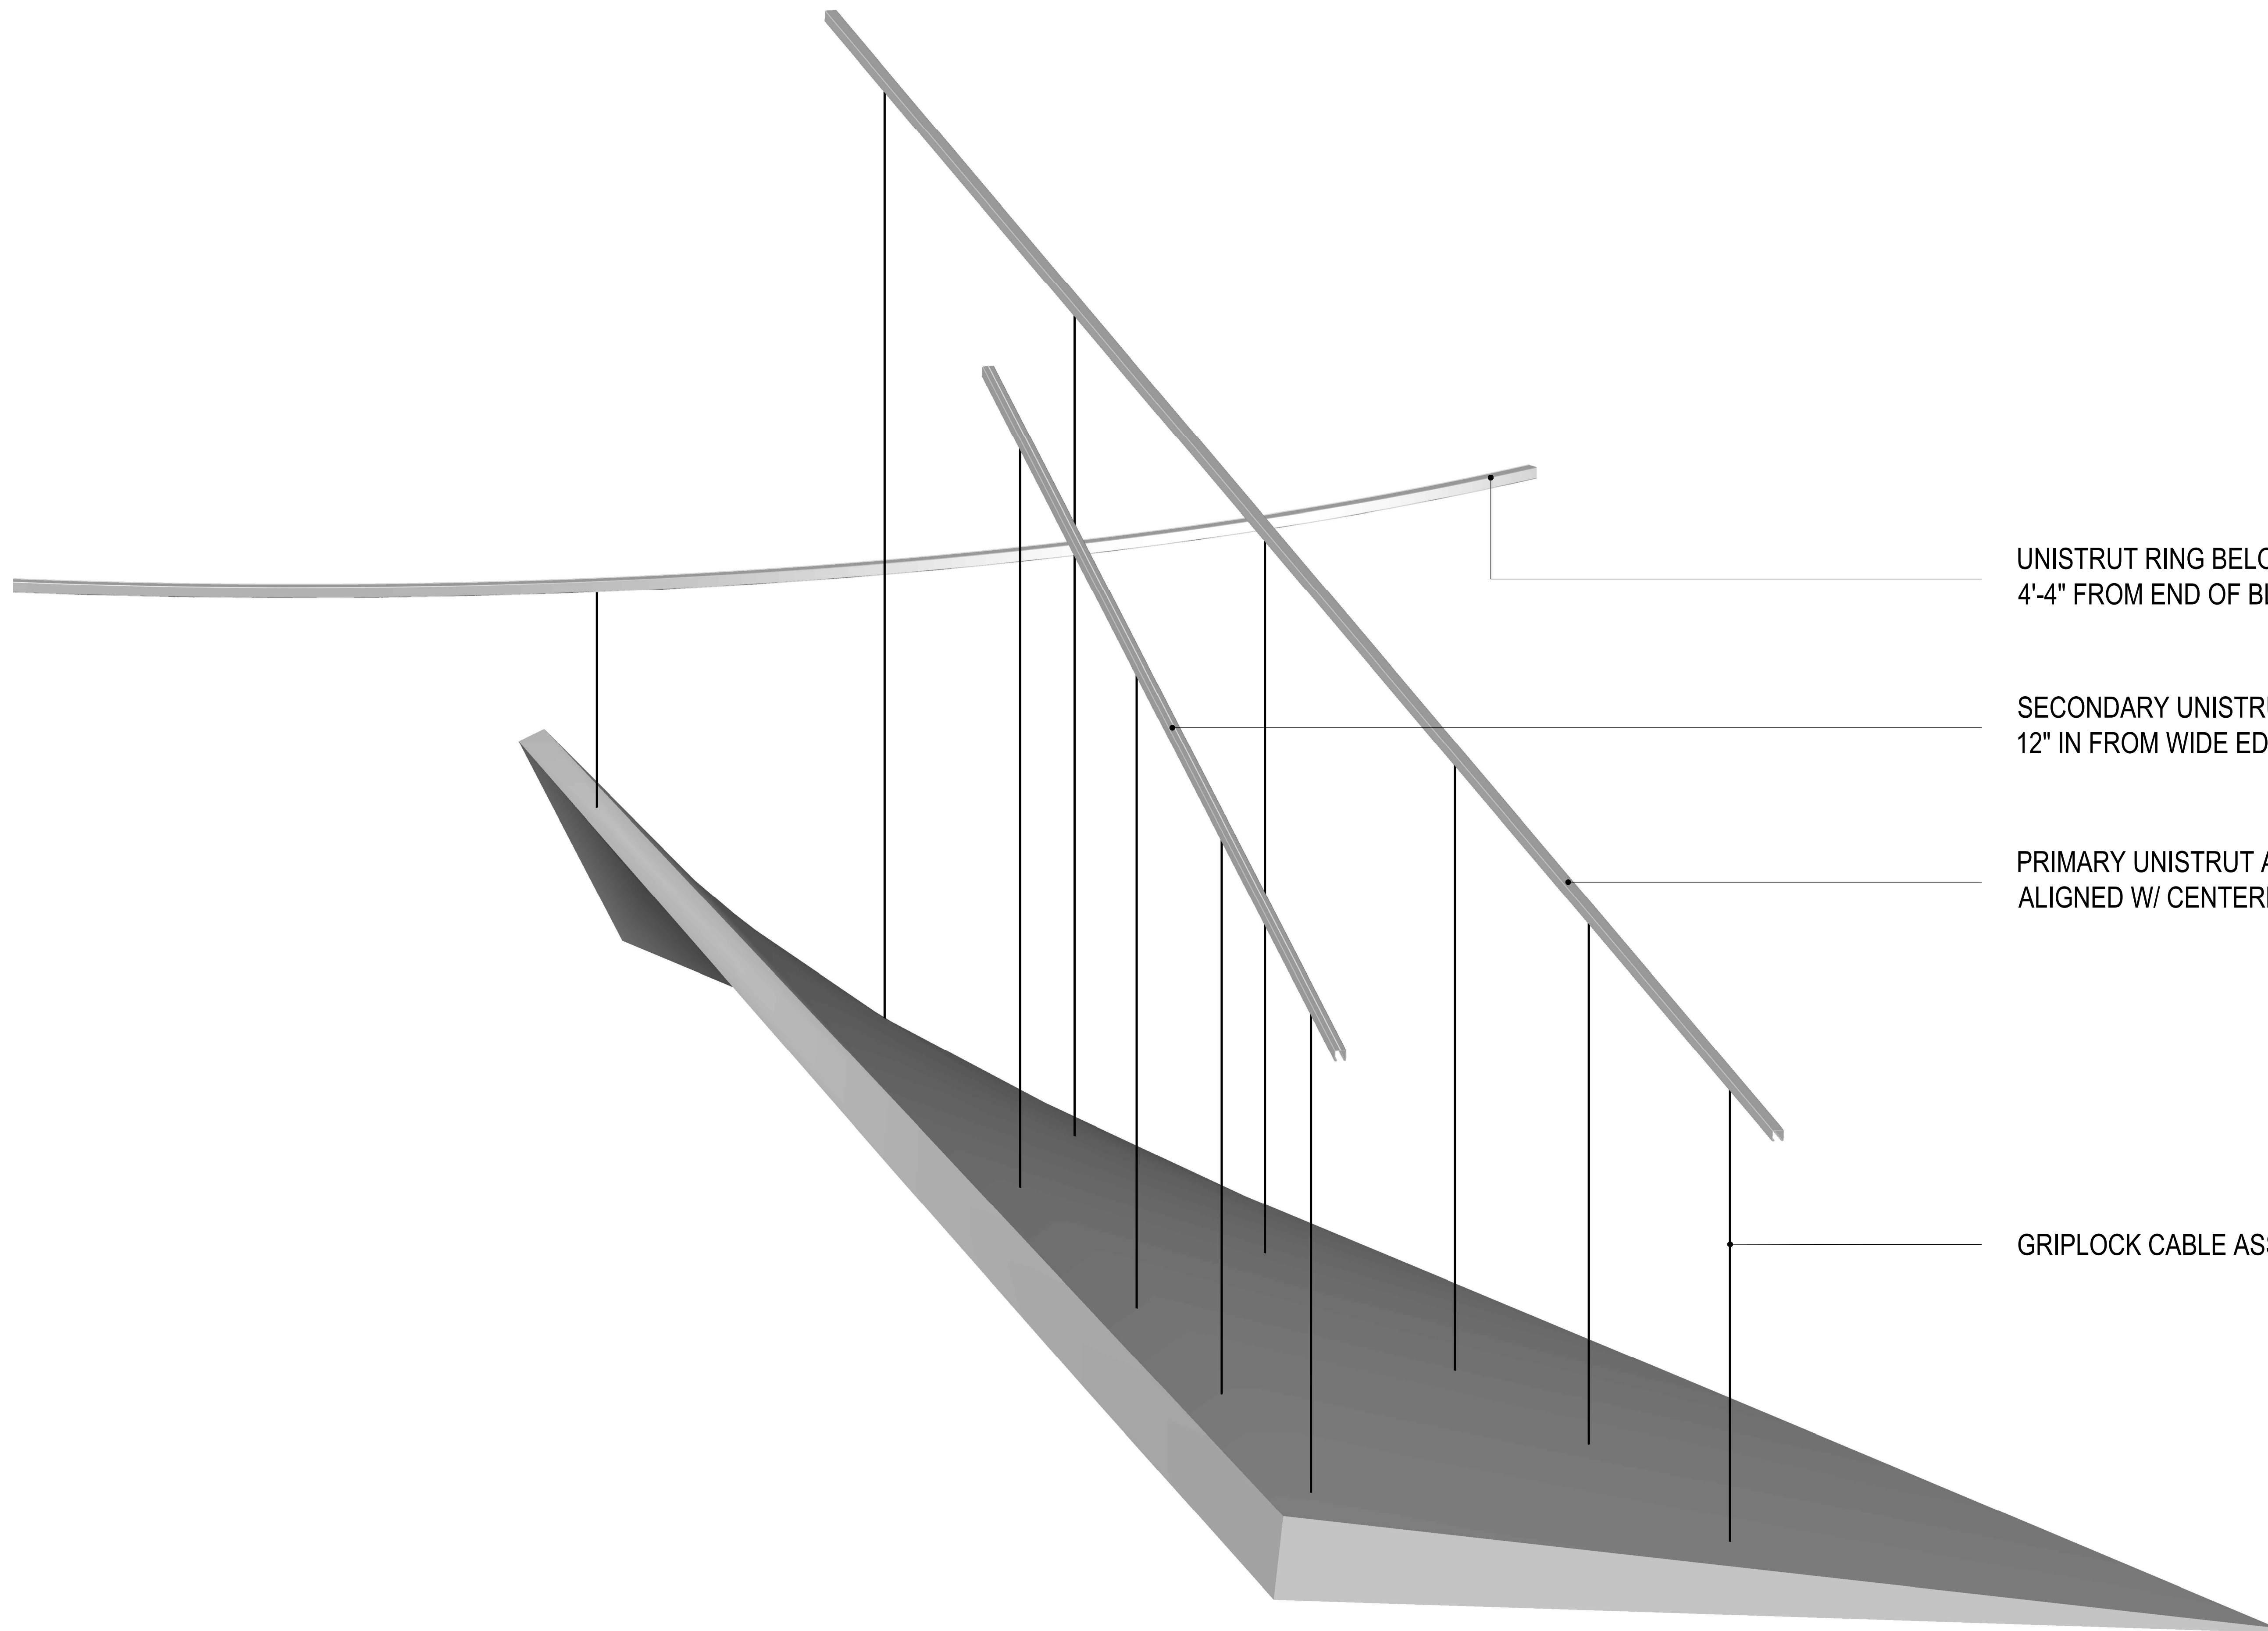

UNISTRUT RING BELOW CATWALK
4'-4" FROM END OF BLADE(BY MAREK BROTHERS)

SECONDARY UNISTRUT ABOVE EACH BLADE
12" IN FROM WIDE EDGE (BY MAREK BROTHERS)

PRIMARY UNISTRUT ABOVE EACH BLADE
ALIGNED W/ CENTERLINE (BY MAREK BROTHERS)

GRIPLOCK CABLE ASSEMBLY

1 VIEW OF SUSPENSION LAYOUT @ TYP BLADE
SCALE: NTS

NOTES:
 1) ALL DIMENSIONS AND LOCATIONS MUST BE V.I.F. PRIOR TO NEWMAT FABRICATION AND INSTALLATION.
 2) ALL DRYWALL APPLICATIONS REQUIRE 12" CONTINUOUS 16GA (MINIMUM) METAL STRAPPING REINFORCEMENT BEHIND DRYWALL AT ALL NEWMAT ATTACHMENT LOCATIONS.
 3) ALL "BLOCKING BY OTHERS", MUST BE CONTINUOUS, STRAIGHT, LEVEL AND/OR PLUMB AND ABLE TO WITHSTAND 30LBS. PER LINEAR FOOT OF LATERAL TENSION WHICH WILL BE EXERTED BY EACH LAYER OF MEMBRANE.

AS BUILT
10/3/2019

NOTICE:
 THESE DRAWINGS WERE PRODUCED BY AND ARE THE SOLE PROPERTY OF NEWMAT USA LTD ANY AND ALL INFORMATION CONTAINED HEREIN SHALL NOT BE USED BY ANY OTHER PERSON OR COMPANY WITHOUT THE EXPRESSED WRITTEN CONSENT OF NEWMAT USA LTD. THE DRAWINGS MAY HAVE BEEN BASED ON CONSTRUCTION DRAWINGS NOT PREPARED BY NEWMAT USA LTD. THEREFORE MAY NOT REPRESENT THE CONDITIONS AS CONSTRUCTED AT THAT TIME.

NEWMAT NORTHEAST CORP. <i>newmat</i> STRETCH CEILING SYSTEMS	#	REVISIONS:	Drawn By	Checked By	81 MAHAN STREET, WEST BABYLON, NY 11704 TEL. (631) 261 1498 FAX (631) 261 1756	Scale:	Drawn By:
	A	2/26/2018	R.K.		DETAIL	AS NOTED	R.K.
	B				AMERICAN AIRLINES	Job Number:	Checked By:
	C				AMERICAN AIRLINES	13-00	Date:
	D					2/14/2018	
E						A-05.1	